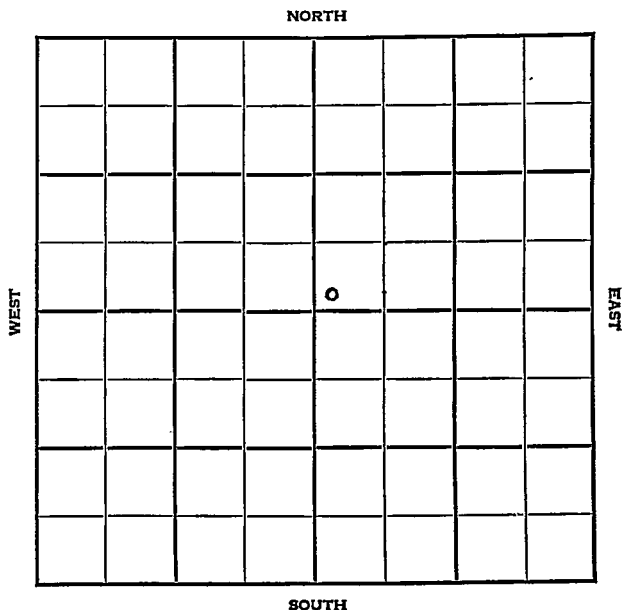


KANSAS

Grant

Section 4 Township 28 Range 37NWell No. #1 Moore "C"Company Stanolind

Grant

Sec. 4 Twp. 28 R. 37W

Well No. #1 Moore "C" Farm

Stanolind

Company

Hugoton


 Ft. from N. Line

150 Ft. from S. Line

 Ft. from E. Line

150 Ft. from W. Line

SW NE

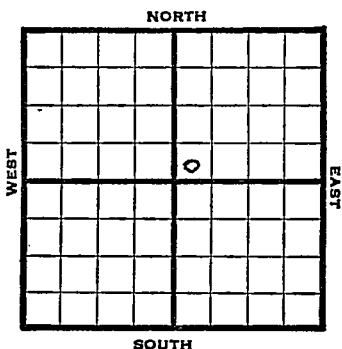

1948

Elev. 3082' REPORT

1/21

Location

1/26

"

2/4

RUR

2/11

10" @ 606'

Drlg. 2395'

2/18

TD 2409'

7" @ 2400'

RUST

2/25

TD 2620'

259' of 5" perf. liner @ 2620'
16,000 acid.

3/3

7" @ 2400'

259' of 5" Perf. Liner 2620'

Acid 16,000

Gas 8,175,000

Rock Pressure 410#

Total Depth 2620'

COMPLETED

Map No. _____ Sec. 4 Twp. 28 R. 37W

Well No. 1 Moore "C"

Stanolind Company

FIRST REPORT Contractor

SW NE

SECTION PLAT

_____ Ft. from N. Line

150 Ft. from S. Line

_____ Ft. from E. Line

150 Ft. from W. Line

		o	

Grant County

Location X

Rig up _____

Drilling and Remarks:

RECORD

Cased _____ in. _____ ft.

Sand _____

Gas _____

Oil _____

Total Depth _____

PRODUCTION

1st 24 hrs. Nat. _____

1st 24 hrs. after shot _____

Gas _____ Cu. Ft.

Dry Hole _____

Abandoned _____

Date

JAN 21 1948 19

S. J. LEWIS

Scout

Kansas

No Map
 Map No. _____ Sec. 4 Twp. 28 R. 37W

Well No. 1 Moore "C"


Stanolind Company

COMPLETE

Contractor

SW NE

E. 3082
 SECTION PLAT

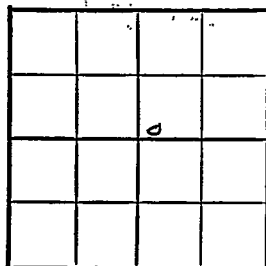

_____ Ft. from N. Line

150 Ft. from S. Line

_____ Ft. from E. Line

150 Ft. from W. Line

Grant County

Location _____

Rig up _____

Drilling and Remarks:

7" @ 2400
258' x 5" Cyl. liner
2620
16000 cu. ft.
8,175,080 Gas
410 L.P.

RECORD

Cased _____ in., _____ ft.

Sand _____

Gas _____

Oil _____

Total Depth 2620

PRODUCTION

1st 24 hrs. Nat. _____

1st 24 hrs. after shot _____

Gas _____ Cu. Ft.

Dry Hole _____

Abandoned _____

Date

MAR 3 1948 19

S. J. LEWIS

Scout