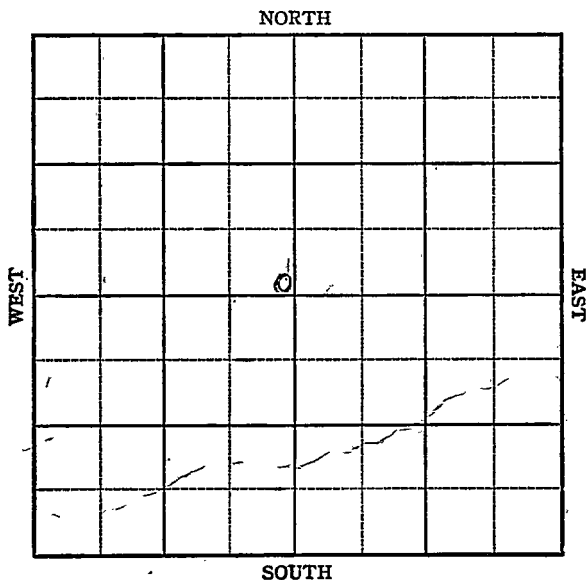


KANSAS

Haskell

FORM 51 IOM 12-46 PETROL

Section 4 Township 28 Range 34WWell No. 1 FletcherCompany Cities Serv.

SAS Haskell

Sec. 4 Twp. 28 R. 34-W

Well-No. #1 Fletcher Farm

Cities Service Company


Hugoton

 Ft. from N. Line

100 Ft. from S. Line

100 Ft. from E. Line

 Ft. from W. Line

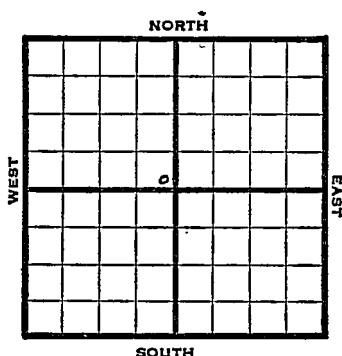

SE NW

1947 Elev. 3078' REPORT

5/14	Location
5/20	"
5/27	"
6/3	"
6/10	"
6/17	8" @ 800' Drlg. 2315'
6/24	TD 2845' 5" @ 2844'
7/1	" "
7/8	110 shots. 2744-66' 70 shots. 2726-40' 80 shots. 2683-98' 100 shots. 2638-58' 45 shots. 2619-28' - 21000 acid.
7/16	12000 Acid
7/22	"
7/29	"

OVER

1947

8/6

5" @ 2844'

Perf

33,000 Acid.

17,800,000 Gas.

R. Pr. 391#

T.D. 2845'

Complete

COMPLETED

Map No. _____ Sec. 4 Twp. 28 R. 34WWell No. 1 Fletcher

_____ Cities Service _____ Company

FIRST REPORT

_____ Contractor

SE NW

SECTION PLAT

_____ Ft. from N. Line

100 Ft. from S. Line100 Ft. from E. Line

_____ Ft. from W. Line

Haskell CountyLocation X

Rig up _____

Drilling and Remarks:

RECORD

Cased _____ in., _____ ft.

Sand _____

Gas _____

Oil _____

Total Depth _____

PRODUCTION

1st 24 hrs. Nat. _____

1st 24 hrs. after shot _____

Gas _____ Cu. Ft.

Dry Hole _____

Abandoned _____

Date

MAY 14 1947 19S. J. LEWIS Scout

Misc. Small Maps

Cards

Tracing

France Map

Scarborough Map

Pierce Map

Geological Dept.

Pierce Plat Book

Kansas Hugoton Pool

Map No. 0 Sec. 4 Twp. 28 R. 34WWell No. 1 Fletcher


Cities Service

Company

COMPLETE

Contractor

SE NW

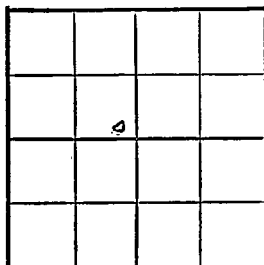E13078
SECTION PLAT Ft. from N. Line100 Ft. from S. Line100 Ft. from E. Line Ft. from W. Line

Haskell County

Location Rig up

Drilling and Remarks:

5102844

Perf.

33000 acid

17,800,000 Gas

391# R/A

RECORD

Cased in., ft.Sand Gas Oil Total Depth 2845

PRODUCTION

1st 24 hrs. Nat. 1st 24 hrs. after shot Gas Cu. Ft.Dry Hole Abandoned

Date

AUG 6 1947 19

S. J. LEWIS

Scout

Misc. Small Maps

Cards

Tracing

France Map

Scarborough Map

Pierce Map

Geological Dept.

Pierce Plat Book