

Section 4 Township 28 Range 39-WWell No. 1 MayerCompany Stanolind

Hugoton Pool

NORTH

WEST

				0			

EAST

SOUTH

KANSAS Stanton

Sec. 4 Twp. 28 R. 39W

Well No. #1 Mayer Farm

Stanolind Company

Hugoton


 Ft. from N. Line

150 Ft. from S. Line

 Ft. from E. Line

150 Ft. from W. Line

SW NE

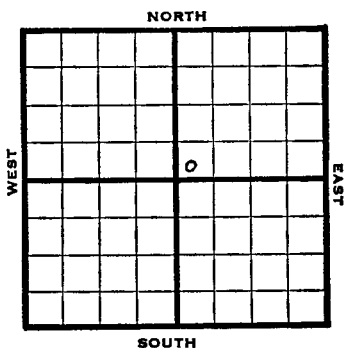

1947 Elev. 3153' REPORT

10/1 Location

10/8 10" @ 616'
TD 2275'
5" @ 2266'

10/15 "

10/22 TD 2466-209' of 5" perf liner
@ 2466 2000 acid

10/29 5" @ 2266'
209' of 5" Perf liner @ 2466'
16,500 Acid
TD 2466'
435# RPr 6,115,000 Gas

COMPLETED

Map No. _____ Sec. 4 Twp. 28 R. 39W

Well No. 1 Hayer

Stanclind Company

FIRST REPORT

Contractor

S. 1/4

SECTION PLAT

		o	

_____ Ft. from N. Line

150 Ft. from S. Line

_____ Ft. from E. Line

150 Ft. from W. Line

Stanton County

Location X

Rig up _____

Drilling and Remarks:

RECORD

Cased _____ in., _____ ft.

Sand _____

Gas _____

Oil _____

Total Depth _____

PRODUCTION

1st 24 hrs. Nat. _____

1st 24 hrs. after shot _____

Gas _____ Cu. Ft.

Dry Hole _____

Abandoned _____

Date

OCT 1 1947 19 S. J. LEWIS Scout

Map No. Sec. 4 Twp. 28 R. 39W

Well No. 1 Mayer


Stanolind Company

COMPLETE

Contractor

SW NE

E1.3143
SECTION PLAT

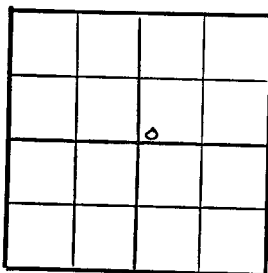

 Ft. from N. Line

150 Ft. from S. Line

 Ft. from E. Line

150 Ft. from W. Line

Stanton County

RECORD

Location

Rig up

Drilling and Remarks:

Cased in., ft.

Sand

Gas

Oil

Total Depth 2466

PRODUCTION

1st 24 hrs. Nat.

1st 24 hrs. after shot

Gas Cu. Ft.

Dry Hole

Abandoned

5' 2266
209' 2" 5" Day liner
2466
16500 acd
6,115,000 cu
4.85 R/R

Date

OCT 29 1947 19

S. J. LEWIS Scout