


KANSAS

Section 5 Township 28 Range 1-W

Well No. #1 Schmitz

Company Eckland Drlg etal
Miscellaneous

NORTH

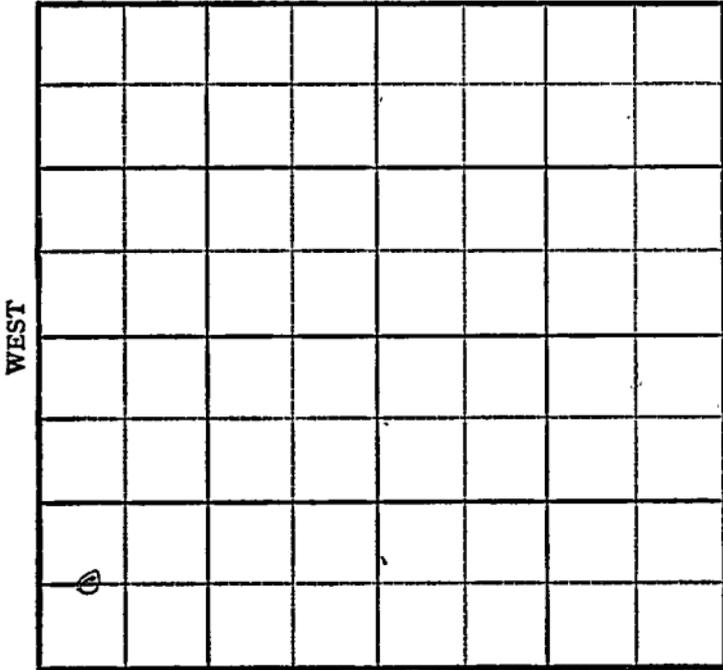

SOUTH

Sedgwick **KANSAS**

Sec. 5 Twp. 28 R. 1W

Well No. #1 Schmitz Farm

Eckland Drlg. et al

Miscellaneous (Eckland, Contr.) Company


_____ Ft. from N. Line

660' Ft. from S. Line

_____ Ft. from E. Line

330' Ft. from W. Line

C W L SW SW

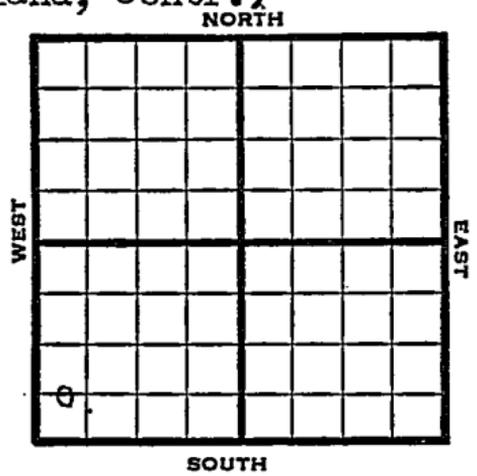

1949 Elev 1332' REPORT

- 11/30 10" @ 149'
- Drlg. 2160'
- 12/7 Lansing 2774'
- Miss 3344-70'
- TD 3370'
- 5" @ 3365'
- 12/14 Drlg. 3385'
- 12/21 TD 3401'
- 12/28 "

- 1950
- 2/1 TD 3401'
- 10" @ 149'
- 5" @ 3365'
- Lans 2774'
- Miss 3344'
- P 30 BOPD
- Comp

COMPLETED

Map No. _____ Sec. 5 Twp. 28 R. 1W

Well No. 1 Schmitz

Eckland Drlg. etal. Company

Eckland Contractor

C W L SW SW

**FIRST REPORT
SECTION PLAT**

_____ Ft. from N. Line

660 Ft. from S. Line

_____ Ft. from E. Line

330 Ft. from W. Line

Sedgwick County

Location _____

Rig up _____

Drilling and Remarks:

10" @ 149

drlg. 2160

RECORD

Cased _____ in., _____ ft.

Sand _____

Gas _____

Oil _____

Total Depth _____

PRODUCTION

1st 24 hrs. Nat. _____

1st 24 hrs. after shot _____

Gas _____ Cu. Ft.

Dry Hole _____

Abandoned _____

Date _____

NOV 30 1949 19 _____

S. J. LEWIS Scout

Kansas

Map No. _____ Sec. 5 Twp. 28 R. 1W

Well No. 1 Schmitz

Eckland Drlg. etal. Company

Contractor

C W L SW SW

Fl. 1332
SECTION PLAT

_____ Ft. from N. Line

660 Ft. from S. Line

_____ Ft. from E. Line

330 Ft. from W. Line

COMPLETE			

Sedgwick County

Location _____

Rig up _____

Drilling and Remarks:

10" @ 149
5" @ 3365
Lans 2774
Miss 3344
P 30 BOPD

RECORD

Cased _____ in., _____ ft.

Sand _____

Gas _____

Oil _____

Total Depth 3401

PRODUCTION

1st 24 hrs. Nat. _____

1st 24 hrs. after shot _____

Gas _____ Cu. Ft.

Dry Hole _____

Abandoned _____

Date

J. E. TYRA

FEB 1 1950 19

Scout