

KANSAS

Sedgwick

Section 5 Township 28 Range 1-W


Well No. #1 Schmidt

Company Polana Pet Corp etal

NORTH

WEST

EAST

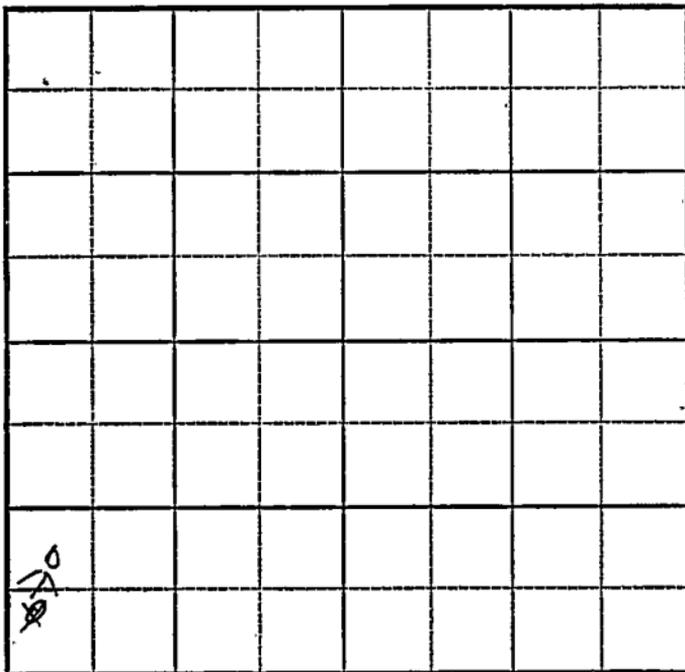

SOUTH

990' F S
330 - W

10
/

Sedgwick

Map No. *Kans* Sec. *5* Twp. *28* R. *1-W*

Well No. *1 - Schmidt* Farm


Marland et al Company
Roxana Per Corp

990 Ft. from N. Line

990 Ft. from S. Line

_____ Ft. from E. Line

330 Ft. from W. Line

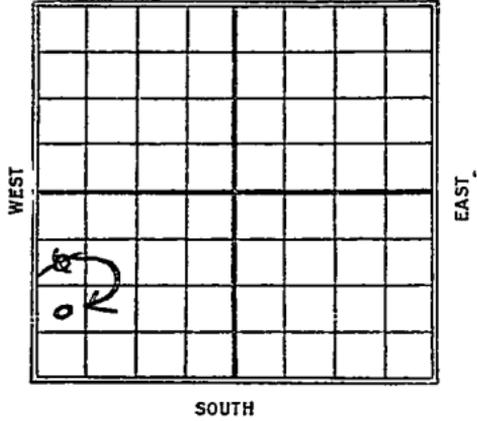

Date	REPORT
<i>1/26</i>	<i>Location</i>
<i>2/2</i>	_____
<i>2/9</i>	_____
<i>2/16</i>	_____
<i>7/23</i>	_____
<i>3/2</i>	_____
<i>3/9</i>	<i>Rigging up</i>
<i>3/16</i>	_____
<i>3/23</i>	<i>Spud</i>
<i>3/30</i>	<i>Spud 100</i>
<i>4/6</i>	<i>Drlg 730</i>
<i>4/13</i>	<i>" 1160</i>
<i>4/20</i>	<i>" 1250</i>
<i>4/27</i>	<i>" 1300</i>
<i>5/4</i>	<i>T.D. 1925 - fishing stem</i>
<i>5/11</i>	<i>T.D. 2025 - str. 8"</i>
<i>5/18</i>	<i>Drlg 2035</i>
<i>5/25</i>	<i>" 2215</i>
<i>6/1</i>	<i>" 2585</i>
<i>6/8</i>	<i>T.D. 2798 show oil - 3gals. per hr. u.R. 8"-</i>
<i>6/15</i>	<i>T.D. 2798 - u.R. 8"-</i>

- 6/22 - T.D. 2910 - H.F.W.
6/29 - Drlg 3165 -
7/9 - T.D. 3397 - 1st break in line
hole full oil - think, will drill
to-wileox -
7/13 - Sand line 3396 - 97 - flowing.
10 bbls. 24 hrs. bldg tanks to Swab
7/20 - Drlg 3540 -
7/27 - T.D. 3680 - H.F.W. - S.D. for orders
8/3 - T.D. 3680 - fishing pipe -
8/10 - Drlg 3710 -
8/17 - Drlg 3782
8/24 - " 3875
8/31 - T.D. 3910 - Shut down -
9/7 - T.D. 3910' D, x D.

Map No. KANSAS Sec. 5 Twp. 28 R. 1W

Well No. 1 Schmidt

Roxana Petroleum Company

Contractor

SECTION PLAT

----- Ft. from N. Line

990 Ft. from S. Line

----- Ft. from E. Line

330 Ft. from W. Line

Correction

Location -----

Rig up -----

Drilling and Remarks:

*Roxana Pet Co
going to operate
this and no 8
Marland.
Reported this
Oct. Nov. SW. should
be Nov. SW. SW.*

RECORD

Cased ----- in., ----- ft.

Sand -----

Gas -----

Oil -----

Total Depth -----

PRODUCTION

1st 24 hrs. Nat. -----

1st 24 hrs. after shot -----

Gas ----- Cu. Ft.

Dry Hole -----

Abandoned -----

Date

MAR 9 1927

S. J. LEWIS

Scout

Returned	
Cards	<i>mm</i>
Tracing	<i>none</i>
France Map	
Scarborough Map	<i>16</i>
Moody Map	
Scarborough Plat Book	
Moody Plat Book	

MAP NO. _____ SEC. 5 TWP. 28S R. 1W

WELL NO. 1 Schmidt

Marland

COMPANY

CONTRACTOR

SECTION PLAT

o			

_____ FT. FROM N. LINE

_____ FT. FROM S. LINE

_____ FT. FROM E. LINE

_____ FT. FROM W. LINE

LOCATION _____

RIG UP _____

DRILLING AND REMARKS:

*OK with
over wall info*

RECORD

CASED _____ IN., _____ FT.

SAND _____

GAS _____

OIL _____

TOTAL DEPTH 2910

PRODUCTION

1ST 24 HRS. NAT. _____

1ST 24 HRS. AFTER SHOT _____

GAS _____ CU. FT.

DRY HOLE

ABANDONED

DATE

9/30 1927

SCOUT

Dee G. Lewis
Map No. 10218 Sec. 5 Twp. 28 R. 1W

Well No. 1 Schmidt

Harland & Co. Company

Contractor

SECTION PLAT

990 Ft. from N. Line

_____ Ft. from S. Line

_____ Ft. from E. Line

330 Ft. from W. Line

0			

FIRST REPORTS

Location ✓

Rig up _____

Drilling and Remarks:

RECORD

Cased _____ in., _____ ft.
 Sand _____
 Gas _____
 Oil _____
 Total Depth _____

PRODUCTION

1st 24 hrs. Nat. _____
 1st 24 hrs. after shot _____
 Gas _____ Cu. Ft.
 Dry Hole _____
 Abandoned _____

Date

JAN 26 1927

S. J. LEWIS

Scout

Returned
Cards **HBK**
Tracing *None*
France 1890
~~Scarborough 1890~~
Moody Map
Scarborough Flat Book
Moody Flat Photo

Map No. KANSAS Sec. 5 Twp. 28 R. 1W

Well No. 1 Schmidt

Roxana P. O. Corp. & Co. Company

Contractor

SECTION PLAT

0			

----- Ft. from N. Line

990 Ft. from S. Line

----- Ft. from E. Line

330 Ft. from W. Line

ABANDONED

Location -----

Rig up -----

Drilling and Remarks:

TII 3910

J & H

RECORD

Cased ----- in., ----- ft.

Sand -----

Gas -----

Oil -----

Total Depth -----

PRODUCTION

1st 24 hrs. Nat. -----

1st 24 hrs. after shot -----

Gas ----- Cu. Ft.

Dry Hole -----

Abandoned -----

Date

SEP 7 1927

S. J. LEWIS

Scout

Returned
Cards	<i>None</i>
Tracing	<i>None</i>
France Map
Scarborough Map
Moody Map
Scarborough First Book
Moody Plat Book