

Sedgwick

KANSAS

SECTION 5 TOWNSHIP 28 RANGE 1 W

WELL NO. #1 Schmidt

COMPANY Eckland Drlg.

NORTH

			0				

WEST

EAST

SOUTH

Sedgwick

KANSAS

SEC.	TWP.	R.
5	28	1W

WELL NO. #1 Schmidt FARM

COMPANY Eckland Drlg


CONTRACTOR Co Tools
Schulte

_____ Ft. from N. Line

_____ Ft. from S. Line

_____ Ft. from E. Line

_____ Ft. from W. Line

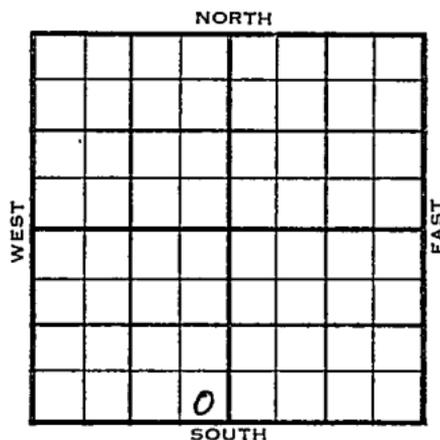

SE SE SW (twin)

1955	ELEVATION 1317'	REPORT
------	--------------------	--------

11/8 Comm 11-1-55
8" @ 140

11-30 DST 2777-82 op 75 min. rec. 240' gas,
20' oil, 36' salty mud, 1015/15"
D & A
H. 2202
KC 2765
M. 3363
TD 3425'

ABANDONED

County Sedwick Elev. _____
 Sec. 5 Twp. 28 Rge. 1W
 Company Eckland Drlg.
 Farm Name Schmidt No. 1

TOPS	DEPTH	LOG	DATUM	Loc. in Sec.
Anh.				SE SE SW
Tp.				
H.				(twin)
Tr.				
Dg.				
Bl.				
L.				Geol. _____
K.C.				Contr. _____
B.K.C.				Co. tools
Ce.				Pool
C.				Schulte
M.				
M.				
K.				
Mz.				
Me.				
V.				
S.				
S.				
A.				
R.				
Pf.				
G.				
T.D.				

NOV 9 '55
 FIRST REPORT
 0

Date Comm. 11-1-55
8" @ 110

Co.
Lse.
No.
Sec.
T.
R.

County Sedgwick Elev. 1317
 Sec. 5 Twp. 28 Rge. 1W
 Company Eckland Drlg.
 FarmName Schmidt No. 1

Co.

TOPS	DEPTH	LOG	DATUM
Anh.			
TP.			
H.	<u>2202</u>		<u>885</u>
Tr.			
Dg.			
Bl.			
L.			
K.C.	<u>2765</u>		<u>1448</u>
B.K.C.			
Ce.			
C.			
M.	<u>3363</u>		<u>2046</u>
M.			
K.			
Mz.			
Mo.			
V.			
S.			
S.			
A.			
R.			
PE.			
G.			
TD.	<u>3425</u>		

Loc. in Sec.

SE SE SW

Geol.

Contr.

Co. tools

Pool

Schulte

ABANDONED

Lse.

No.

Sec.

T.

R.

Date Comm.

11-1-55

NOV 3 0 1955

8" @ 140 DST 2777-82 open 75 min.

rec. 240' gas 20' oil 36' salty mud

1015/15"

D & A