


Section 5 Township 28 Range 1W

Well No. #1 Harns

Company Aladdin Pet.
Schulte Pool

NORTH

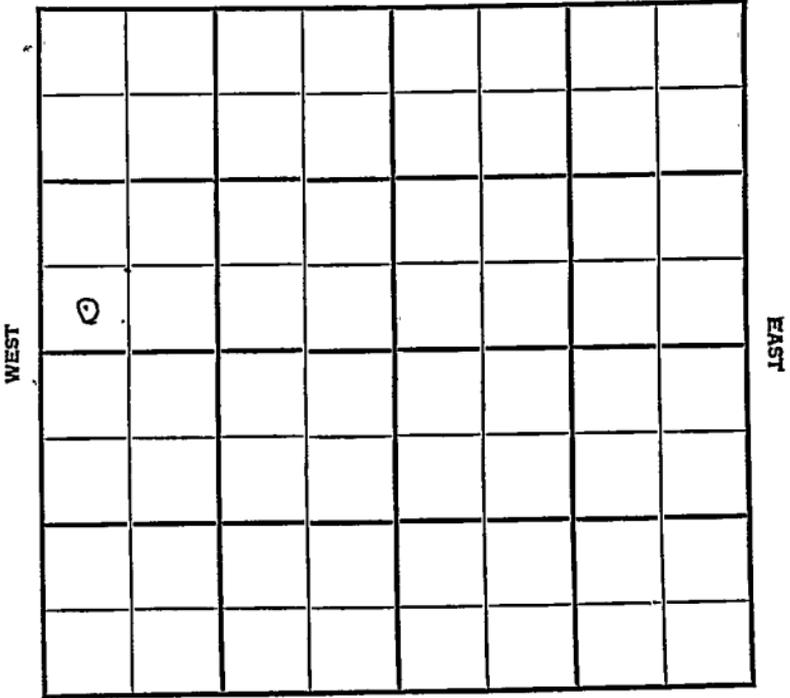

SOUTH

WEST

EAST

Sec. 5 Twp. 28 R. 1W

Well No. #1 Harns Farm

Aladdin Pet. Company

Schulte


Ft. from N. Line

330 Ft. from S. Line

Ft. from E. Line

330 Ft. from W. Line

SW NW

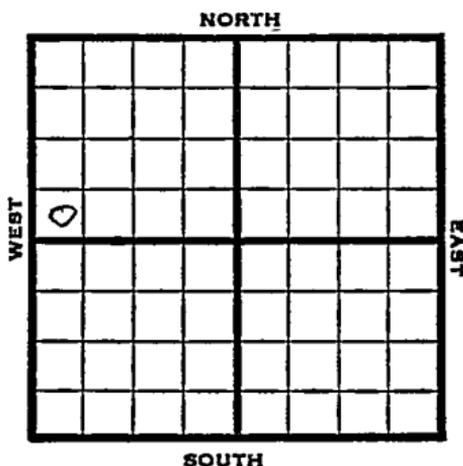

1948

Elev. -

R E P O R T

4/14

Location

4/21

Drlg. 750'

4/28

8" @ 155'
Drlg. 3100'

5/5

Miss 3346'
Simp. 3677'
TD 3687'

ABANDONED

Map No. _____ Sec. 5 Twp. 28 R. 1W

Well No. 1 Harns

Aladdin Pet. _____ Company

FIRST REPORT

Contractor

SW NW


SECTION PLAT

_____ Ft. from N. Line

330 Ft. from S. Line

_____ Ft. from E. Line

330 Ft. from W. Line

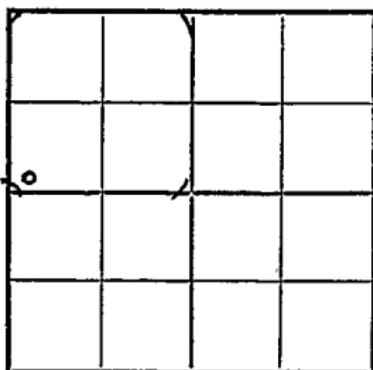

Sedgwick County

Location X

Rig up _____

Drilling and Remarks:

RECORD

Cased _____ in., _____ ft.

Sand _____

Gas _____

Oil _____

Total Depth _____

PRODUCTION

1st 24 hrs. Nat. _____

1st 24 hrs. after shot _____

Gas _____ Cu. Ft.

Dry Hole _____

Abandoned _____

Date

APR 14 1948 19

S. J. LEWIS Scout

