

Kingman KANSAS

Well No. # 1 Ramsdale

Company Laura Jane Oil

WEST

EAST

0

SOUTH

Kingman KANSAS

SEC.	TWP.	R.
5	28	5W

WELL NO.

1 Ramsdale

FARM

COMPANY

Laura Jane Oil

CONTRACTOR

Shawver-Armour
Casley Pool


330 Ft. from N. Line

Ft. from S. Line

330 Ft. from E. Line

Ft. from W. Line

NE NE SE

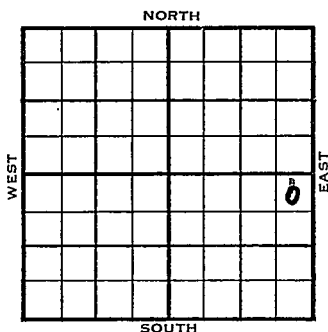

	ELEVATION	REPORT
1955	11428'	

2/16 Spud 2-15-55
Setting Surface

4/13 Spud 2-15-55 Oil well TD 3815
8" @ 162 Lans 2955
DST 3248-68 open 1 hr gas in 55 min
rec 25' HGCM, 30' O & GCM, 120' HO &
GCM, 150' free oil, 300' OCM, 1145#
Miss 3761
DST 3784-94 open 1 hr rec 185' MW,
1356#. TD 3815 5" @ 3350 CO to
3260' 18/3248-51 S/1½ BOPH 6 hr.
P/75 BO 24 hr. Comp. 43 BOPD 1% wtr.

COMPLETED

FABEN GILSTRAP

FABEN GILSTRAP