


Section 5 Township 28 Range 5W

Well No. #1 Ramsdale

Company Pabco Drlg.

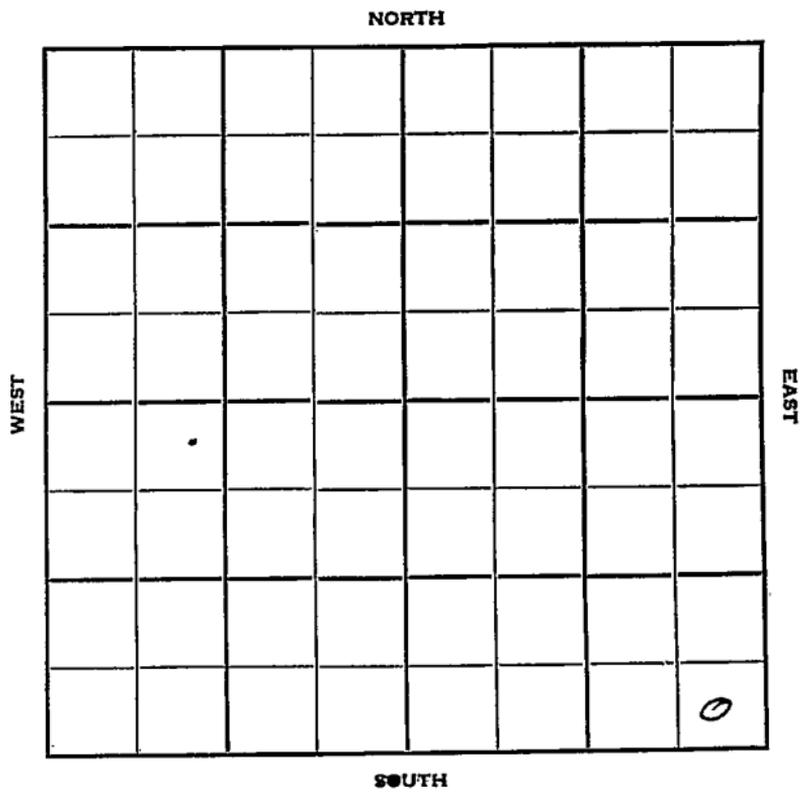

Kingman

KANSAS

Sec. 5 Twp. 28 R. 5 W ✓

Well No. # 1 Ramsdale Farm

Pabco Drlg. Company

Contractor


Ft. from N. Line

330 Ft. from S. Line

330 Ft. from E. Line

Ft. from W. Line

SE SE SE

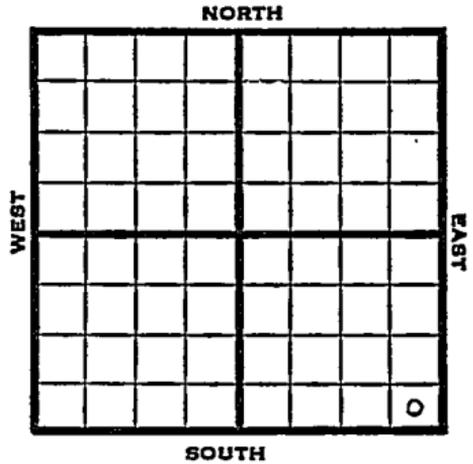

1951

Elev. 1418'

REPORT

6/6

Spud 5-30-51
8" @ 155
Drlg. 2640'

9/5

Spud 5-30-51
D&A TD 3880
8" @ 155
Br. lime 2948 Lans. 2964
Miss 3747 Dol. 3777
DST 3777-90 open 1 hr. rec. 300' oil
5" @ 3777 TD 3790
S/ 1 bo 1 bwph 1000 A DD 3880
D&A

ABANDONED

