
FORM 51 10M 8-47

KANSAS Grant

Section 5 Township 28 Range 37W

Well No. #1 Hoffman

Company Stanolind

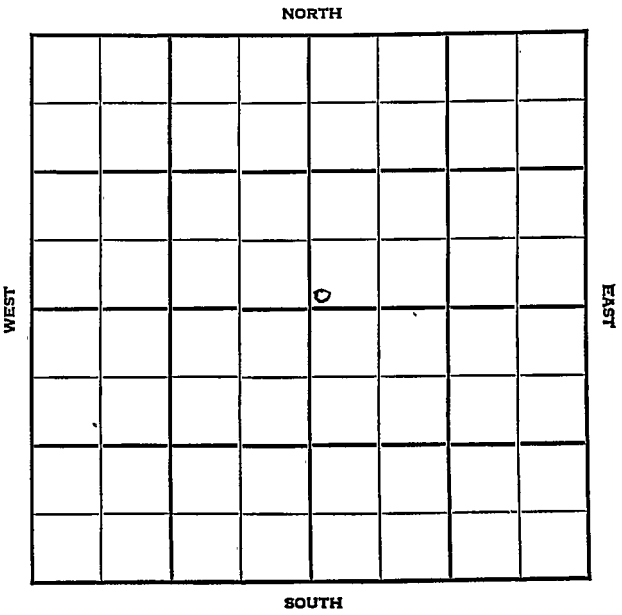

FORM 252-A
5M 9-47 PETROL

Grant KANSAS

Sec. 5 Twp. 28 R. 37W

Well No. #1 Hoffman Farm

Stanolind Company

Hugoton


____ Ft. from N. Line

150 Ft. from S. Line

____ Ft. from E. Line

150 Ft. from W. Line

SW NE

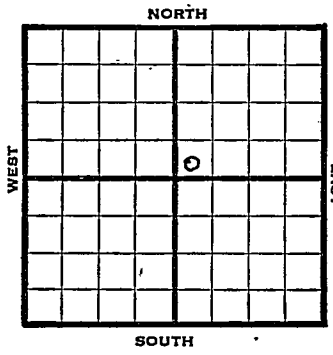

REPORT

1948	Elev. 3082'
1/21	Location
1/26	10"@ 613' WOC
2/4	TD 2495' 7" @ 2487'
2/11	TD 2595'
2/18	TD 2995' 7" @ 2487' 221' of 5" Perf. liner @ 2995' 2000 acid 7,322,000 gas 412# R. Pr. TD 2995' Comp.

COMPLETED

Form 26 - 200 Bks. 10-46 Petrol

Kansas

Hugoton Pool

Map No. _____ Sec. 5 Twp. 28 R. 37W


Well No. 1 Hoffman

Stanolind Company

FIRST REPORT Contractor

SW NE

SECTION PLAT

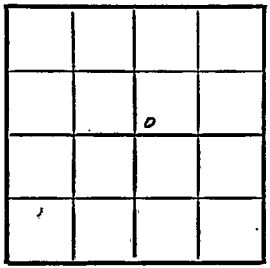

_____ Ft. from N. Line

150 Ft. from S. Line

_____ Ft. from E. Line

150 Ft. from W. Line

Grant County

Location x

Rig up _____

Drilling and Remarks:

RECORD

Cased _____ in., _____ ft.

Sand _____

Gas _____

Oil _____

Total Depth _____

PRODUCTION

1st 24 hrs. Nat. _____

1st 24 hrs. after shot _____

Gas _____ Cu. Ft.

Dry Hole _____

Abandoned _____

Date

JAN 21 1948 19

S. J. LEWIS Scout

Form 26 200 Bks. 10-46 Petrol

Hugoton Pool

No Map Kansas

Map No. _____ Sec. 5 Twp. 28 R. 37W

Well No. 1 Hoffman


Stanolind Company

COMPLETE Contractor

SW NE

L.P. 3082

SECTION PLAT

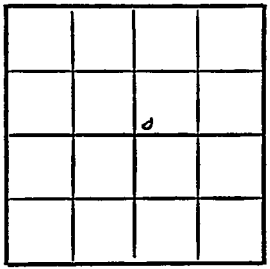

_____ Ft. from N. Line

150 Ft. from S. Line

_____ Ft. from E. Line

150 Ft. from W. Line

Grant County

Location _____

Rig up _____

Drilling and Remarks:

TD 2995

7" @ 2987

221' of 5" Perf liner @ 2995

20000 Gal. Acid

7,322,000 Gas

412 # P. Pr.

RECORD

Cased _____ in., _____ ft.

Sand _____

Gas _____

Oil _____

Total Depth 2995

PRODUCTION

1st 24 hrs. Nat. _____

1st 24 hrs. after shot _____

Gas _____ Cu. Ft.

Dry Hole _____

Abandoned _____

Date

FEB 18 1948 19

S. J. LEWIS Scout