


FORM 51 Haskell

Section 5 Township 28 Range 33W

Well No. 1 Curry

Company J. M. Huber Corporation

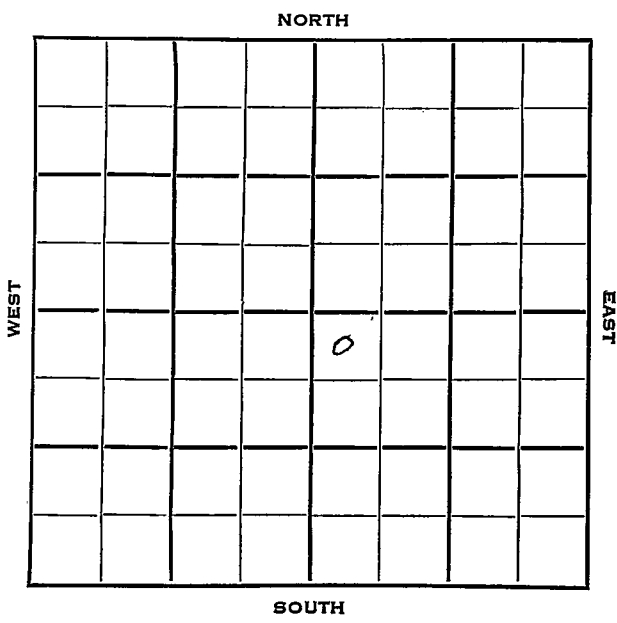

Sec. 5 Twp. 28 R. 33W

Well No. #1 Curry Farm

J. M. Huber Corp. Company


Contractor

150 Ft. from N. Line

_____ Ft. from S. Line

_____ Ft. from E. Line

150 Ft. from W. Line

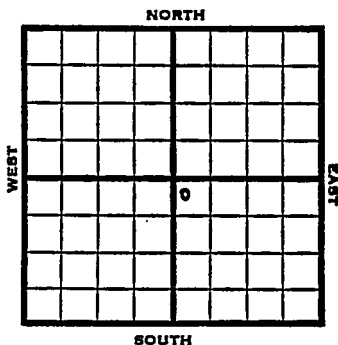

NW SE

1953 Elev. 3013 REPORT

1/14 Spud 1-9-53
8" @ 818
Drlg. 1735'

1/22 NR

1/29 RTD 2760' 5" @ 2759' DD 2794' by
mistake. PB 2776 1000 A 2 BWPH
2000 A Her 2710' Up Kr 2738'
Low Kr 2758'

2/5 58/2738-48, 5000A.

2/11 Spudding Date 1/9/53
D&A TD 2794
8" @ 818 Her. 2710 Kri. 2738
5" @ 2759 TD 2760 DD 2794 PB 2776
1000 A . 2 bwph 2000 A 58/2738-48
5000 A wtr.
D&A

ABANDONED

