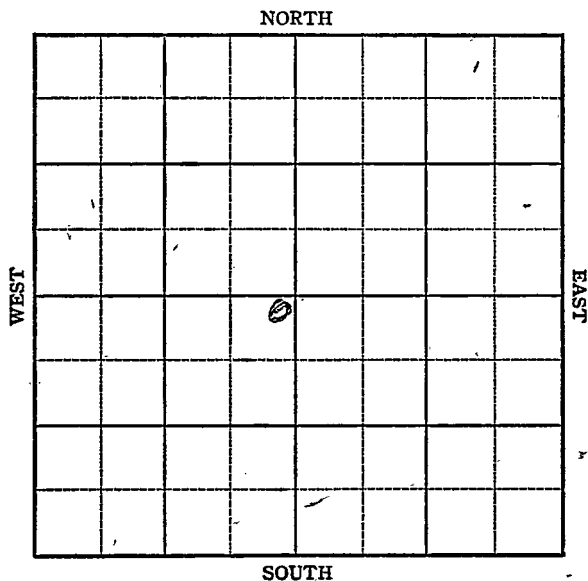


KANSAS

Haskell

FORM 51 IOM 12-46 PETROL

Section 5 Township 28 Range 34WWell No. 1 ElliottCompany Cities Service

KANSAS Haskell

Sec. 5 Twp. 28 R. 34-W

Well No. #1 Elliott Farm

Cities Service Company


Hugoton

100 Ft. from N. Line

 Ft. from S. Line

100 Ft. from E. Line

 Ft. from W. Line

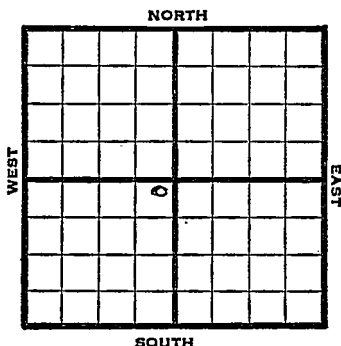

NE SW

1947 Elev. 3070' REPORT

5/14	Location
5/20	"
5/27	"
6/3	"
6/10	"
6/17	"
6/24	RUR
7/1	8" @ 800' Drlg 2488'
7/8	TD 2835' 5" @ 2834'
7/16	"
7/22	29000 acid
7/29	"
8/6	"
8/13	"
8/20	"

OVER

1947

8.27

5" @ 2834'

Perf.

29,000 Acid

10,500,000 Gas

Total Depth 2835'

COMPLETED

Map No. _____ Sec. 5 _____ Twp. 28 _____ R. 34W _____

Well No. 1 Elliott _____

_____ Cities Service _____ Company

FIRST REPORT

_____ Contractor

NE SW

SECTION PLAT

100 Ft. from N. Line

_____ Ft. from S. Line

100 Ft. from E. Line

_____ Ft. from W. Line

	0		

Haskell County

Location X _____

Rig up _____

Drilling and Remarks:

RECORD

Cased _____ in., _____ ft.

Sand _____

Gas _____

Oil _____

Total Depth _____

PRODUCTION

1st 24 hrs. Nat. _____

1st 24 hrs. after shot _____

Gas _____ Cu. Ft.

Dry Hole _____

Abandoned _____

Date

MAY 14 1947

19

S. J. LEWIS

Scout

Misc. Small Maps _____

Cards DLG _____

Tracing _____

France Map _____

Scarborough Map _____

Pierce Map _____

Geological Dept. _____

Pierce Plat Book _____

Map No. 0 Sec. 5 Twp. 28 R. 34W

Well No. 1 Elliott

Cities Service Company

COMPLETE

Contractor

NE SW


E1,2070
SECTION PLAT

100 Ft. from N. Line

 Ft. from S. Line

100 Ft. from E. Line

 Ft. from W. Line

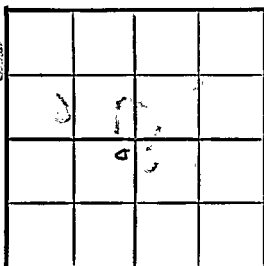

Haskell County

Location

Rig up

Drilling and Remarks:

5' @ 2834

Perf.

29000000 oil

10,500,000 Gas

378 R.R.

RECORD

Cased in., ft.

Sand

Gas

Oil

Total Depth 2835

PRODUCTION

1st 24 hrs. Nat.

1st 24 hrs. after shot

Gas Cu. Ft.

Dry Hole

Abandoned

Date

AUG 27 1947 19

S. J. LEWIS

Scout

no money

Misc. Small Maps	☒
Cards	☒
Tracing	☒
France Map	☒
Scarborough Map	☒
Pierce Map	☒
Geological Dept.	☐
Pierce Plat Book	☐