

Ford


KANSAS

SECTION 5 TOWNSHIP 28S RANGE 21W

WELL NO. #1 Blurton

COMPANY Ben J. Taylor

NORTH C NE NE

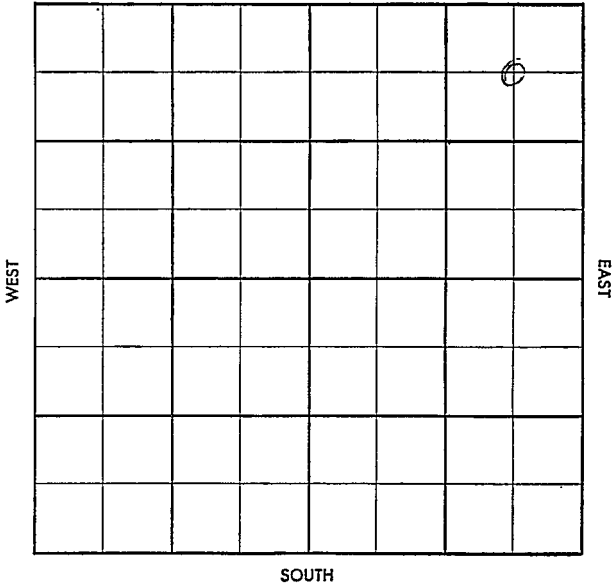

~~Top~~ ~~Pool~~
WILDCAT
~~Co.~~ ~~Facet~~

S-513-B

County Ford Elev. _____
 Sec. 5 Twp. 28 Rge. 21W
 Company Ben J. Taylor
 Farm Name Blurton No. 1

TOPS	DEPTH	LOG	DATUM
Anh.			
Tp.			
H.			
Tr.			
Dg.			
B.L.			
L.			
K.C.			
B.K.C.			
Ce.			
C.			
M.			
M.			
K.			
Mz.			
Mq.			
V.			
S.			
S.			
A.			
R.			
Pf.			
G.			
T.D.			

Loc. in Sec. _____

C NE NE

Geol. _____

Contr. _____

Armer #H-40

Pool _____

Wildcat

FIRST REPORT AUG 6 '58		38	0

Date Comm. 8-4-58
8" @ 198 w/150, WOC

Co.

Lse.

No.

Sec.

T.

R.

Top 117 Pool 117

Facet 117

S-513-B

21

County Ford Elev. 27.511 2 12/17
 Sec. 5 Twp. 28 Rge 21W
 Company Ben J. Taylor
 Farm Name Blurton No. 1

TOPS	DEPTH	LOG	DATUM
Anh.			
Tp.			
H.	<u>4120</u>		
Tr.			
Dg.			
B.L.			
L.	<u>4257</u>		
K.C.			
B.K.C.			
Ce.			
C.			
M.			
M.	<u>4908</u>		
<u>Milam</u>	<u>4934</u>		
Mz.			
Mq.			
V.			
S.			
S.			
A.			
R.			
Pf.			
G.			
T.D.	<u>5035</u>	<u>5037</u>	

Loc. in. Sec.

C NE NE

Geol.

C. Becker

Contr.

Armer #H-40

Pool

Wildcat

SEP 3 '58

ABANDONED

Date Comm.

8-4-58

Run 108 W/150, WOC AUG 13 '58

Ø 2835

Ø 4342 AUG 27 '58

DST 4916-90 30" 26' Mud

81P 50-20

TD 5035 Log SEP 3 '58

Log same as sample

Do A