

Stanton

KANSAS


Section 5 Township 28 Range 39W

Well No. 1 Winger

Company Stanolind

Hugoton

NORTH

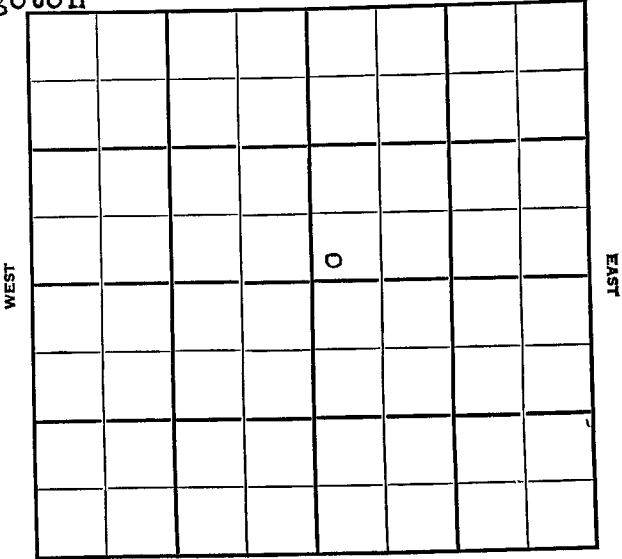

SOUTH



Sec. 5 Twp. 28 R. 39W

Well No. #1 Winger Farm
Stanolind Company


Hugoton
Ft. from N. Line

150 Ft. from S. Line

 Ft. from E. Line

150 Ft. from W. Line

SW NE

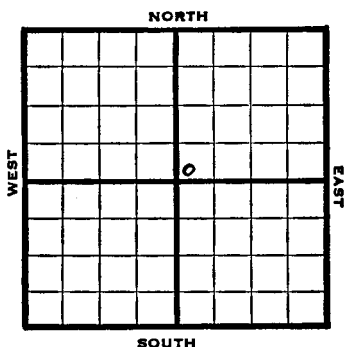

	Elev. 3183' REPORT
1947	
11/5	RUR
11/12	10" @ 699' Drlg. 1789'
11/19	TD 2290' 7" @ 2285'
11/25	"
12/3	TD 2485' 206' of 5" Perf. liner @ 2845' 17000 acid.
12/10	7" @ 2285' 206' of 5" Perf. liner @ 2485' 17,000 acid. 4,250,000 gas. 415# R. Pr. TD 2485'
	COMPLETED

Map No. _____ Sec. 5 Twp. 28 R. 39W


Well No. 1 Winger

Stanolind Company

FIRST GEORGE Contractor

SW NE

SECTION PLAT

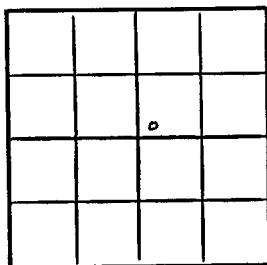

_____ Ft. from N. Line

150 Ft. from S. Line

_____ Ft. from E. Line

150 Ft. from W. Line

Stanton County

Location _____

Rig up _____

Drilling and Remarks:

R U R

RECORD

Cased _____ in., _____ ft.

Sand _____

Gas _____

Oil _____

Total Depth _____

PRODUCTION

1st 24 hrs. Nat. _____

1st 24 hrs. after shot _____

Gas _____ Cu. Ft.

Dry Hole _____

Abandoned _____

Date

NOV 5 1947 19

S. J. LEVINS


Scout

Map No. _____ Sec. 5 Twp. 28 R. 39WWell No. 1 Winger

Stanolind _____ Company

COMPLETE _____ Contractor

SW NE

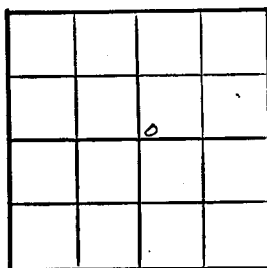E 1/3 1/8
SECTION PLAT

_____ Ft. from N. Line

150 Ft. from S. Line

_____ Ft. from E. Line

150 Ft. from W. Line

Stanton County

Location _____

Rig up _____

Drilling and Remarks:

7" @ 2253-
206' of 5" Prof. liner
@ 2473
17000 Acid
4, 200, 000 Gas
4 1/2" R.P.

RECORD

Cased _____ in., _____ ft.

Sand _____

Gas _____

Oil _____

Total Depth 2473

PRODUCTION

1st 24 hrs. Nat. _____

1st 24 hrs. after shot _____

Gas _____ Cu. Ft.

Dry Hole _____

Abandoned _____

Date

DEC 1 1947

19

S. J. LEWIS

Scout