



KANSAS

*Sedgwick*  
28 1<sup>st</sup>

Map No. \_\_\_\_\_ Sec. 6 Twp. \_\_\_\_\_ R. \_\_\_\_\_

Well No. 2- Gillespie Farm \_\_\_\_\_

D. R. Latch Company \_\_\_\_\_


330 Ft. from N. Line

\_\_\_\_\_ Ft. from S. Line

330 Ft. from E. Line

\_\_\_\_\_ Ft. from W. Line

Elev. 1338

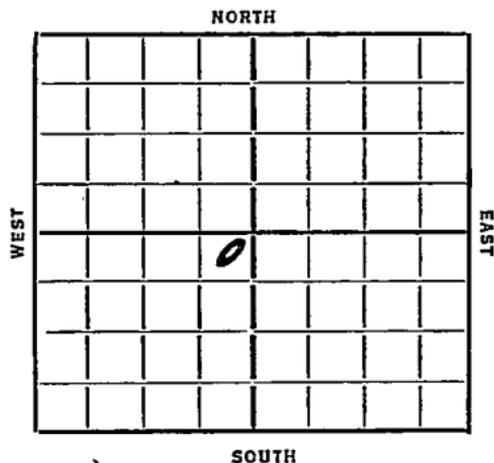

REPORT

~~10/35~~  
 10/2 Cellar  
 10/10 dly 172  
 11/1 TD 1670 HFW WR  
 11/7 dly 2555  
 11/14 KC 2809 8" 2941  
 dly 3045  
 11/21 Top Chub 3385 6" 3372  
 Oil 3482-91  
 11/27 dly. 3693  
 TD 3694

*Do Ft.*

ABANDONED

Map No. 38 Sec. 6 Twp. 28 R. 1 W

Well No. 2-Gillespie

H. R. Lauck Company

Contractor

FIRST REPORTS

SECTION PLAT

330 Ft. from N. Line

..... Ft. from S. Line

330 Ft. from E. Line

..... Ft. from W. Line

	0		

Location.....

Rig up.....

Drilling and Remarks:

cellar

RECORD

Cased..... in., ..... ft.

Sand.....

Gas.....

Oil.....

Total Depth.....

PRODUCTION

1st 24 hrs. Nat.....

1st 24 hrs. after shot.....

Gas..... Cu. Ft.

Dry Hole.....

Abandoned.....

Date

10-7-35 192.....

ORVAL MANNSCHRECK

Scout

Map No. 38 Sec. 6 Twp. 28 R. 1W

Well No. 2 - Gillespie

D. R. Lauck Company

Contractor

**COMPLETE**

SECTION PLAT

330 Ft. from N. Line

..... Ft. from S. Line

330 Ft. from E. Line

..... Ft. from W. Line

		o	

Location.....

Rig up.....

Drilling and Remarks:

10 + N

RECORD

Cased..... in..... ft.

Sand 1101 3693

Gas.....

Oil.....

Total Depth 3694

PRODUCTION

1st 24 hrs. Nat.....

1st 24 hrs. after shot.....

Gas..... Cu. Ft.

Dry Hole.....

Abandoned.....

Date

11-27-35 192

W. M. SCHREIBER

Scout