


Section 6 Township 28 Range 3W

Well No. #1 Jordon

Company Aladdin Pet.
Curry Pool

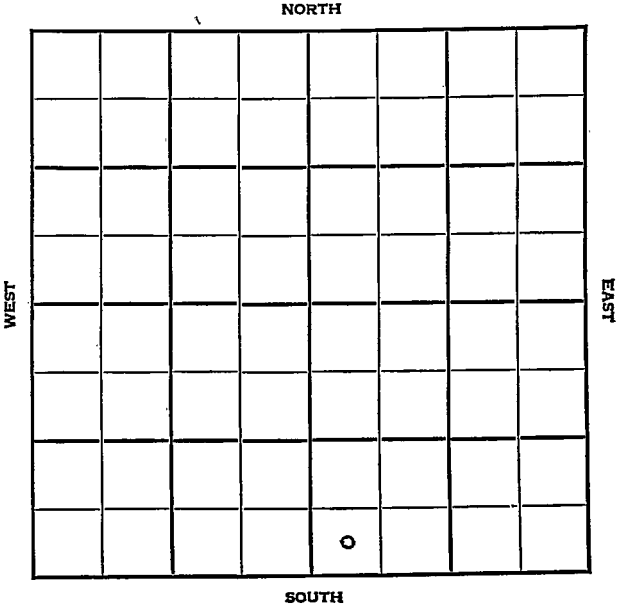

KANSAS

Sedgwick



Sec. 6 Twp. 28 R. 1W

Well No. #1 Jordon Farm

Aladdin Pet. Company

Curry Pool


_____ Ft. from N. Line

330' Ft. from S. Line

_____ Ft. from E. Line

330' Ft. from W. Line

SW SE

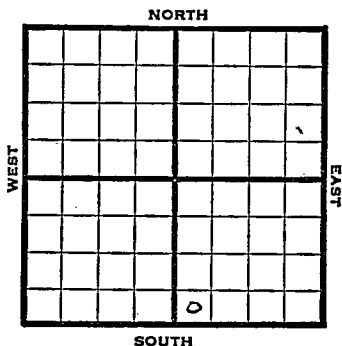

1948	Elev. 1339' REPORT
3/17	8" @ 164' Drlg. 825'
3/24	Drlg. 2995'
3/31	Mississippi 3346' Drlg. 3700'
4/7	5" @ 3685' TD 3700' RUST
4/14	42 shots 3670-82 HFO
4/21	Pump & flow 50 oil & 150 W a day
4/28	Simp. 3673' 5" @ 3683' Water TD 3700' ABANDONED

Map No. _____ Sec. 6 Twp. 28 R. 1WWell No. 1 JordonAladdin Pet. _____ Company-IRST REPORT _____ Contractor

SW SE

SECTION PLAT

_____ Ft. from N. Line

330 Ft. from S. Line

_____ Ft. from E. Line

330 Ft. from W. LineSedgwick County

Location _____

Rig up _____

Drilling and Remarks:

8" @ 164drlg. 825

RECORD

Cased ^{in.} _____ in., _____ ft.

Sand _____

Gas _____

Oil _____

Total Depth _____

PRODUCTION

1st 24 hrs. Nat. _____

1st 24 hrs. after shot. _____

Gas _____ Cu. Ft.

Dry Hole _____

Abandoned _____

Date

MAR 17 1948

19

S. J. LEWIS Scout

Map No. 38 Sec. 6 Twp. 28 R. 1W

Well No. 1 Jordon

Aladdin Pet. Company

ABANDONED Contractor

SW SE

E. J. 1358
SECTION PLAT

 Ft. from N. Line

330 Ft. from S. Line

 Ft. from E. Line

330 Ft. from W. Line

Sedgwick County

Location

Rig up

Drilling and Remarks:

Surf 3673
5' C 3683
Water

RECORD

Cased in., ft.

Sand

Gas

Oil

Total Depth 13206

PRODUCTION

1st 24 hrs. Nat.

1st 24 hrs. after shot

Gas Cu. Ft.

Dry Hole

Abandoned

Date

APR 28 1948 19 S. J. LEWIS Scout