


Sedgwick

Form 51-5M-11-31-Palace

Map No. **KANSAS** Sec. *6* Twp. *28* R. *1W*

Well No. *1 Gillespie* Farm
D Lauch Company

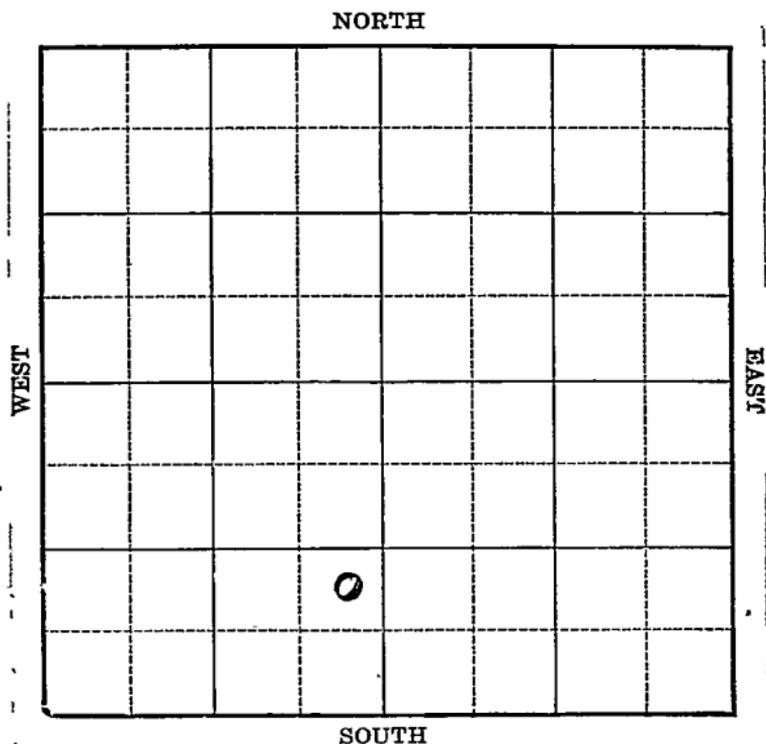

Location _____

Drilling Remarks _____

RECORD

Cased _____ in. _____ ft.

Sand _____

Gas _____

Oil _____

Total Depth _____

Rig Up _____

Drilling Remarks _____

PRODUCTION

1st 24 hrs. Nat. _____

1st 24 hrs. after shot _____

Gas _____ cu. ft.

Dry Hole _____


Abandoned _____

Sedgwick

Map No. **KANSAS** Sec. 6 Twp. 28 R. 1W

Well No. 1 Gillespie Farm
D Launch Company

_____ Ft. from N. Line
990 Ft. from S. Line
330 Ft. from E. Line
_____ Ft. from W. Line

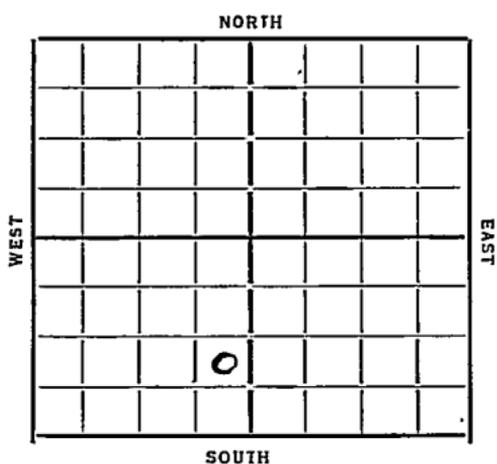

Date	REPORT
1934	
3/21	Moving in
3/29	_____
4/5	Rig
4/12	_____ 4/19 _____
4/26	Rign up
5/3	Dlg 385
5/10	2 nd sq. 405
5/18	20" 167 15 1/2 390
5/25	12" 1556 10" 2063
5/31	Dlg 2065
6/7	" 2655
6/14	Dlg 3125 K.C. 2984 8" 3021
6/21	" 3525 chst 3333 6" 3330
6/28	TD 3638 P.A.P.
7/5	TV 3686 147 5/6 3689
7/12	TD 3691 PB 3400
7/18	PB 3400 1000 acid
	Viola 3686 TD 3691
	PB 3400 1000 acid D & A

ABANDONED

KANSAS

Map No. 38 Sec. 6 Twp. 28 R. 1W

Well No. 1- Gillespie

D. Lauck Company

Contractor

FIRST REPORT

SECTION PLAT

..... Ft. from N. Line

990 Ft. from S. Line

330 Ft. from E. Line

..... Ft. from W. Line

Location.....

Rig up.....

Drilling and Remarks:

moving in

RECORD

Cased.....in.,ft.

Sand.....

Gas.....

Oil.....

Total Depth.....

PRODUCTION

1st 24 hrs. Nat.....

1st 24 hrs. after shot.....

Gas.....Cu. Ft.

Dry Hole.....

Abandoned.....

Date

3/21/37 192

O. Manschreck Scout

mo
- 5-1-2

Returned	
Cards	<i>Red</i>
Tracing	<i>Red</i>
France Map	<i>X</i>
Scarborough Map	<i>X</i>
Moody Map	<i>X</i>
Scarborough Plat Book	
Moody Plat Book	

Map No. 38 Sec. 6 Twp. 28 R. 1W

Well No. 1-Millipie

Lanck et al Company

Contractor

ABANDONED

SECTION PLAT

		0	

_____ Ft. from N. Line

990 Ft. from S. Line

330 Ft. from E. Line

_____ Ft. from W. Line

Location _____

Rig up _____

Drilling and Remarks:

PB 3400
1000 acid

DAF

RECORD

Cased _____ in. _____ ft.

Sand Viola 3686

Gas _____

Oil _____

Total Depth 3691

PRODUCTION

1st 24 hrs. Nat. _____

1st 24 hrs. after shot _____

Gas _____ Cu. Ft.

Dry Hole _____

Abandoned _____

Date

7-18-34 19

ORVAL MANNSCHEDECK
Scout

no

no

no

no

no

no

no