

Section 6 Township 28 Range 4 W

Well No. # 1 Pipkin (C)

Company W. C. McBride

NORTH

WEST

EAST

0

SOUTH

Sedgwick

KANSAS



Sec. 6 Twp. 28 R. 4W

Well No. #1 Pipkin (C) Farm

W. C. McBride Company

Jackson - Contr. Contractor


330' Ft. from N. Line

Ft. from S. Line

990' Ft. from E. Line

Ft. from W. Line

NW NE SW

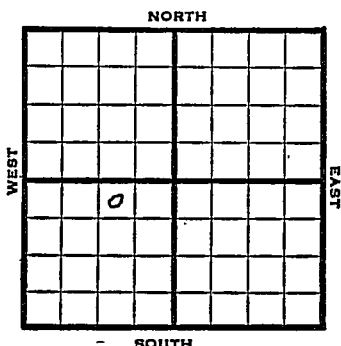


1952 Elev. 1408 REPORT

5/21 RU
5/28 10" @ 104
8" @ 244
Br Li 2864 Drlg. 2955
6/11 TD 3764'
5" @ 3748'
6/18 DP
6/25 DP 3764 1000 A F 116 BO
4 hrs. POP
7/2 NR
7/9 Spud 5-19-52
Oil Well TD 3764
10" @ 104 8" @ 244
Br Lime 2863 Lans. 2924
Miss 3730 Dol. 3750
DST 3748-64 opn 1 hr. gas in. 20
min Rec. 585' oil 15' o & gcmw 1175#
TD 3764 5" @ 3748 GO to 3764
1000 A F/116 BO 4 hr. Comp. 163 bopd

COMPLETED

J. G. McGENEE

County Sedgwick State Kansas
 Sec. 6 (Blk. 28 (Sur. 4W Map No.)
 Operator W. C. McBride
 Well No. 1 Farm Pipkin "C"
 Elev. 1408 Location NW NE SW

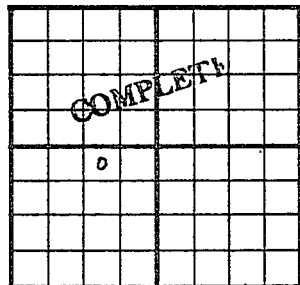

330 Ft. From N Line SW
990 Ft. From E Line Quarter
 1st. Report
 Completion JUL 9 1952
 Remarks Jackson Drlg. - Contr.
 Spudding Date 5-19-52

Drlg. Data Oil well TD 3764
10" @ 104 8" @ 244 Br. lime 2863
Lans. 2924 Miss. 3730 Dol. 3750
DST 3748-64 open 1 hr. gas in 20 min.
Rec. 585' oil 15' o & gcmw 1175#
TD 3764 5" @ 3748 CO to 3764 1000 A
F/ 116 bo 4 hr. Comp. 163 bopd

J. G. McGEHEE