


Section 6 Township 28 Range 4W

Well No. #1 Pipkin "A"

Company W. C. McBride Inc.

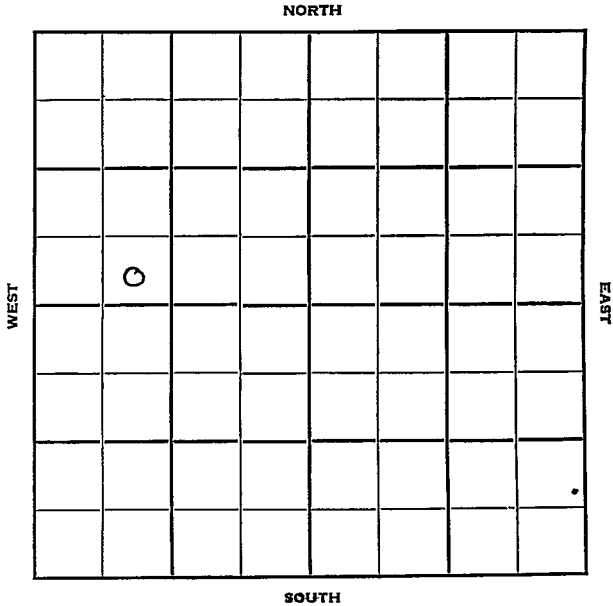

Sec. 6 Twp. 28 R. LW

Well No. #4 Pipkin "A" Farm

W. C. McBride Inc. Company

Jackson Drlg. Contractor


_____ Ft. from N. Line

330 Ft. from S. Line

_____ Ft. from E. Line

990 Ft. from W. Line

SE SW NW

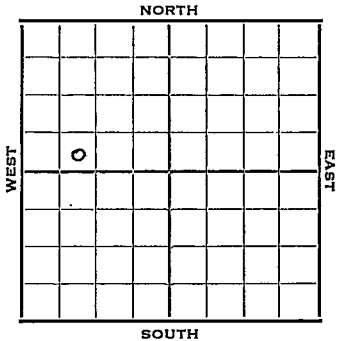

1952

Elev. 1412' REPORT

4/22

Spud 4-20-52
13" @ 100' 8" @ 204'

4/30

Drlg. 994'
Drlg. 3347'

5/7

Lans. 2914 Miss Chert 2713
Miss Dol 3744
Coring 3744-68 TD Full Rec. SSO
DST 3744-68 1 hr. gas in 48" 210' OGM
120' MCO 1170# 15" FP 15#
5" @ 3744

5/14

RUST

5/21

DP 3768' 1000 A 39 BO 2 hrs.

5/28

PB 3859 F 66 BO 17 hrs. by heads

6/11

NR

6/18

NR

6/25

"

7/2

Spud 4-20-52
Oil well TD 3768' 13" @ 100
8" @ 204' Lans. 2914' Miss chert
3713' Miss. dol. 3744'
DST 3744-68 open 1 hr. gas in 48 min.
rec 210' OGM, 120' MCO 5" @ 3744
DP 3768' 1000 A 39 BO 2 hr.
P B 3859' F/66 BO 17 hr.
Comp. 72 BOPD

COMPLETED

