


Section 6 Township 28 Range 4 W

Well No. # 3 Pipkin "A"

Company McBride

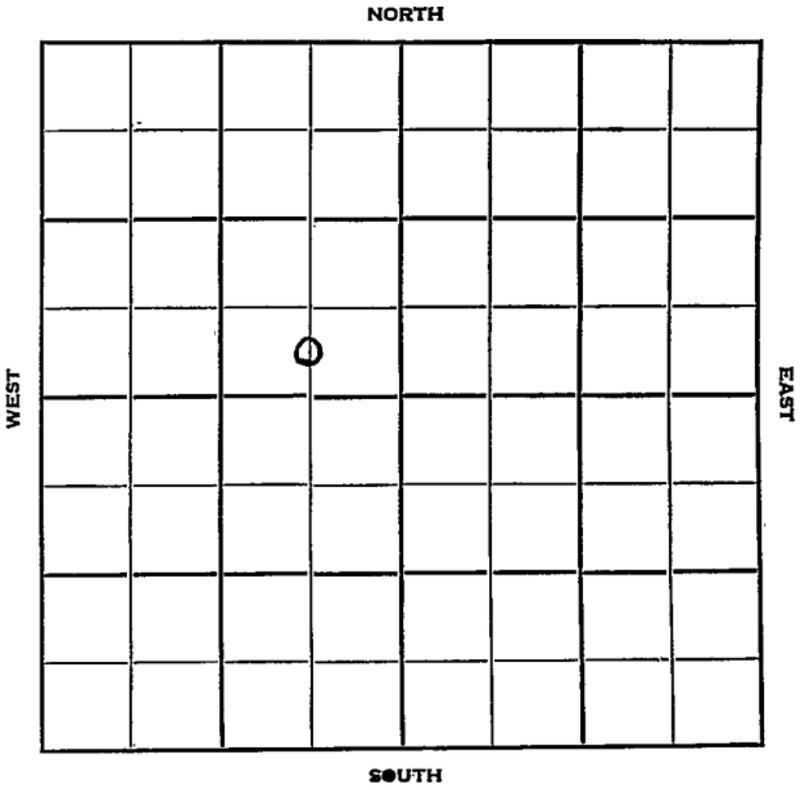

Sedgwick **KANSAS**

Sec. 6 Twp. 28 R. 4W

Well No. #3 Pipkin "A" Farm

McBride Company

Jackson Drlg. - Contr. Contractor


Bartholomew Pool

_____ Ft. from N. Line

330' Ft. from S. Line

660' Ft. from E. Line

_____ Ft. from W. Line

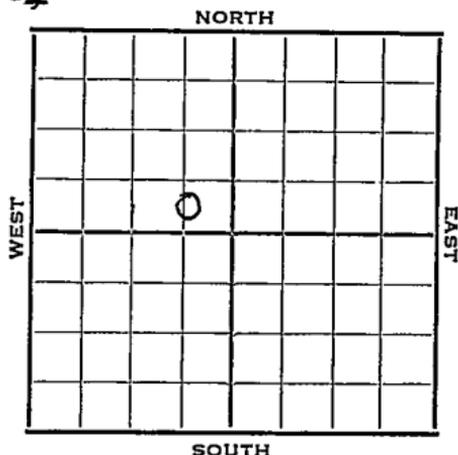

C S L SE NW

1952 Elev. 1408' REPORT

2/20 Spud 2-16-52
10" @ 202
WOC

3/5 Br Li 2862 Lans. 2922 Mis 3731
DST 3757-80 1 hr. 305 HO&GCM
1000# RTD 4780 7" @ 3766
WOCT

3/12 DO to 3780 Rung tub to A

3/19 DD to 3782' TD 1000 A
F/38 BO 1st hr, 20 BO 2nd hr.
15 BO 3rd Hr. Shut down 24 hrs. /
S/43 BO 2 hrs. POP

3/26 NR

4/9 Spud 2-16-52
Oil Well TD 3782
10" @ 202 Br Lime 2862 Lans. 2922
Miss 3731
DST 3757-80 opn 1 hr. Rec. 305' ho
& gcm TD 3780 7" @ 3766
DO 3780 DD 3782 1000 A F 38 bo 1 hr.
20 bo 2nd hr. 15 bo 3rd hr.
Shut down 24 hr. S/43 bo 2 hrs.
Comp. 315 bopd

COMPLETED


County Sedgwick State Kansas

Sec. 6 (Blk. 28 (Sur. 4W (Twp.) (Rge.) Map No.

Operator McBride

Well No. 3 Farm Pipkin "A"

Elev. 1408 Location C S L SE NW

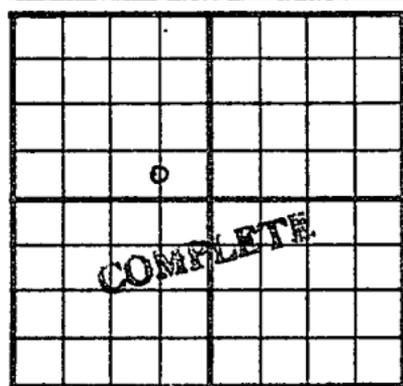

330 Ft. From S Line NW

660 Ft. From E Line Quarter

Ist. Report

Completion APR 9 1952

Remarks Bartholomew Pool

Jackson Drlg. - Contr.

Spudding Date 2-16-52

Drlg. Data Oil well TD 3782

10" @ 202 Br. lime 2862 Lans. 2922

Miss. 3731 DST 3757-80 open 1 hr.

Rec. 305' ho & gcm TD 3780 7" @ 3766

DO 3780 DD 3782 1000 A F/ 38 bo 1 hr

20 bo 2nd hr. 15 bo 3rd hr.

shut down 24 hr. S/ 43 bo 2 hr.

Comp. 315 bopd