

Sedgwick


KANSAS

Section 6 Township 28 S Range 4W

Well No. #2 Pipkin

Company W. C. McBride

NORTH

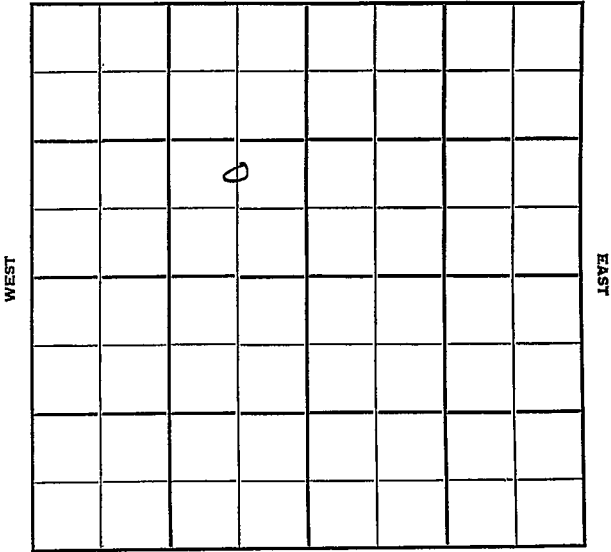

SOUTH

Sedgwick

KANSAS
R. 4 W

Sec. 6 Twp. 28

Well No. # 2 Pipkin Farm

W. G. McBride Company

Jackson Drlg. Contractor


Bartholomew Pool

Ft. from N. Line

990 Ft. from S. Line

660 Ft. from E. Line

Ft. from W. Line

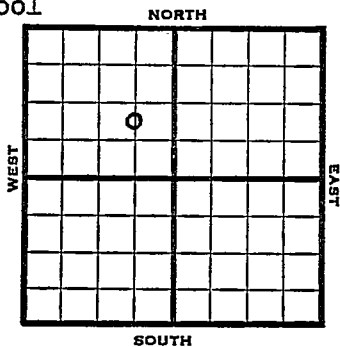

C N L SE NW

1952

Elev. 1409' REPORT

1/2

Location

2/6

Spud 1-3-52
 Oil Well TD 3767
 10" @ 199
 KC 3907 Miss 3712
 DST 3748-65 opn 1 hr. Rec. 130' ho
 & gcm 415' gassy oil 4' wtr
 TD 3765 5" @ 3750 DD 3767
 1000 A F/107 bo 1 hr
 Comp. BHB 3000 bopd

COMPLETED

