


Section 6 Township 28 Range 4WWell No. #4 McIntoshCompany W. C. McBride

NORTH

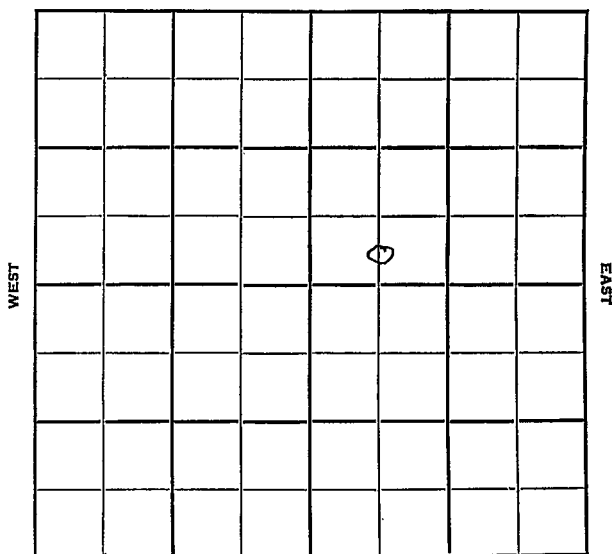

SOUTH

Sedgwick

KANSAS

Sec. 6 Twp. 28 R. 4W

Well No. #4 McIntosh Farm

W. C. McBride Company

Jackson - Contr. Contractor


 Ft. from N. Line

330' Ft. from S. Line

 Ft. from E. Line

660' Ft. from W. Line

C S/2 SW NE

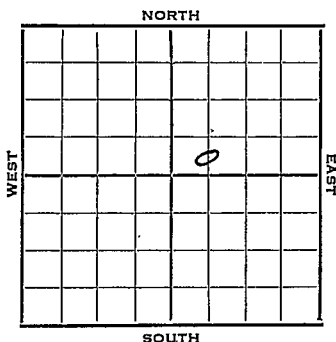

1952 Elev. 1402' REPORT

5/7 Spud 5-4-52
8" @ 240
WOC

5/14 Drlg. 3330'
5/21 Br Li 2870
TD 3820'

5/28 Br Li 2870 TD 3820
Miss 3740 DST 3790-3820 1 hr.
1500' SW 550# RTD 3822 5" @ 3820
DP CO 13/3790-94 500 A

6/11 Spud 5-4-52
Oil Well TD 3822' 8" @ 240
Br Li 2870 Miss. 3740
DST 3790-3822 open 1hr. rec. 1500'
SW TD 3822 5" @ 3820
13/ 3790-94 500 A
Comp. 30 bopd 147 bw

COMPLETED

County Sedgwick State Kansas
 Sec. 6 (Blk.) 28 (Sur.) 4W Map No.
 Operator W. C. McBride
 Well No. 4 Farm McIntosh
 Elev. Location C S/2 SW NE

330 Ft. From S Line NE

660 Ft. From W Line Quarter

Ist. Report MAY 7 1952

Completion

Remarks


Jackson - Contr.

Spudding Date 5-4-52

Drig. Data

8" @ 240 W.O.C.

J. G. MCGEHEE

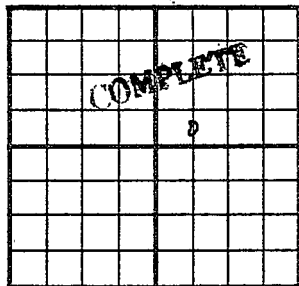County Sedgwick State KansasSec. 6 (Blk.) 28 (Sur.) 4W Map No.Operator W. C. McBrideWell No. 4 Farm McIntoshElev. 1402 Location C S L SW NE330 Ft. From S Line NE660 Ft. From W Line Quarter

1st. Report

Completion JUN 11 1952

Remarks

Jackson Drlg. - Contr.Spudding Date 5-4-52Drlg. Data Oil well TD 38228" @ 240 Br. lime 2870 Miss. 3740DST 3790-3822 open 1 hr. Rec. 1500' swTD 3822 5" @ 3820 13/ 3790-94 500 AComp. 30 bopd 147 bw

J. G. McGEHEE