


Section 6 Township 28 Range 4W

Well No. #2 McIntosh

Company W. C. McBride

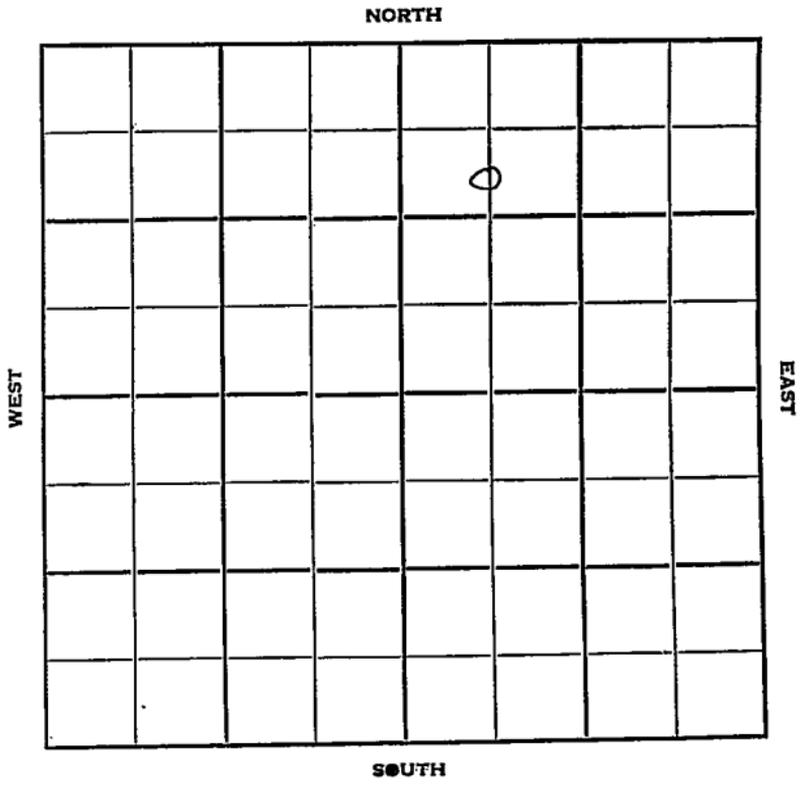

Sec. 6 Twp. 28 R. 4W

Well No. #2 McIntosh Farm

W. C. McBride Company

Contractor

**Barthlemew**


990' Ft. from N. Line

\_\_\_\_\_ Ft. from S. Line

\_\_\_\_\_ Ft. from E. Line

660' Ft. from W. Line

**C S/2 NW NE**

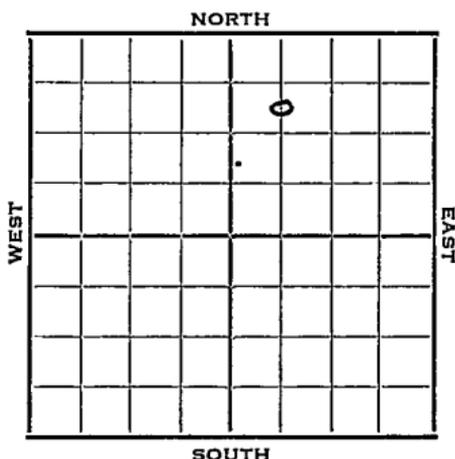

1952

Elev. 1403'

REPORT

1/30

Location

2/6

"

2/13

Br Li 2855

Drlg. 3312'

2/20

TD 3775' 7" @ 3766

3/5

Oil Well TD 3780

10" @ 205

Br li 2855

Miss Chat 3725

Miss dol. 3770

DST 3750-75 open 1 hr. rec. 90'

O&GCM 180' vh &GCM 120' free oil

TD 3780 1000 A F/ 128 bo 1½ hr.

Comp. BHB 1053 bopd

**COMPLETED**


County Sedgwick State Kansas

Sec. 6 (Blk. Twp.) 28 (Sur. Rge.) 4W Map No.

Operator W. C. McBride

Well No. 2 Farm McIntosh

Elev. Location C S/2 NW NE

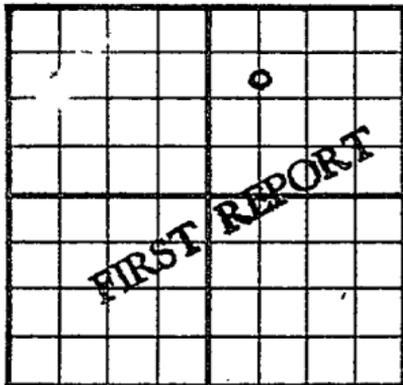

990 Ft. From N Line NW

660 Ft. From W Line Quarter

Ist. Report JAN 30 1952

Completion

Remarks

Spudding Date

Drlg. Data Barthlemew

Location

J. G. MCGEHEE.

