


Section 6 Township 28 Range 4W

Well No. #3 Davis (B)

Company Westgate Greenland

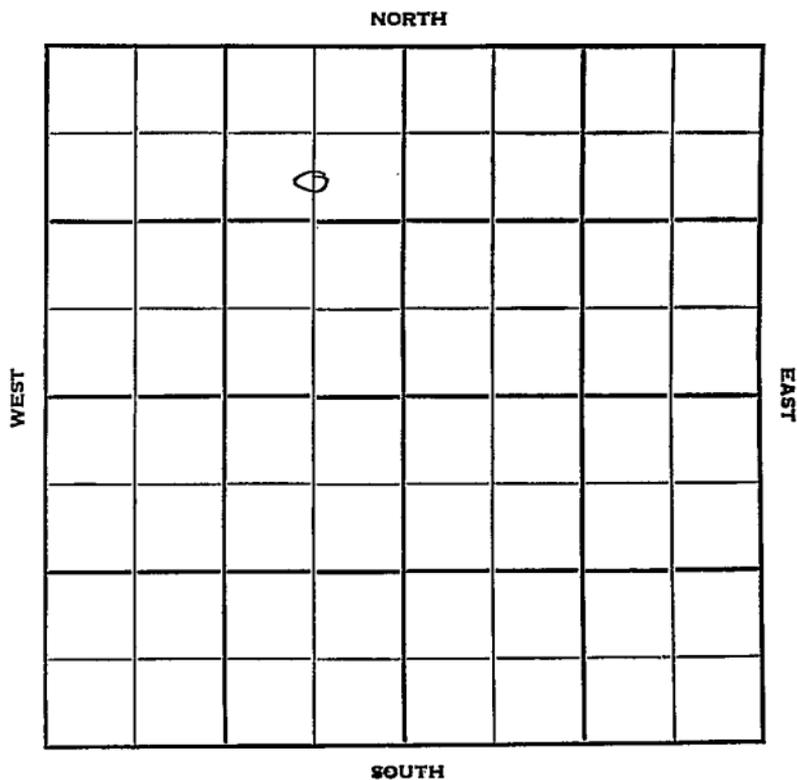

Sedgwick

KANSAS

Sec. 6 Twp. 28 R. 4W

Well No. #3 Davis (B) Farm

Westgate Greenland Company

Contractor

Barthlemew


990 Ft. from N. Line

_____ Ft. from S. Line

660 Ft. from E. Line

_____ Ft. from W. Line

C S/2 NE NW

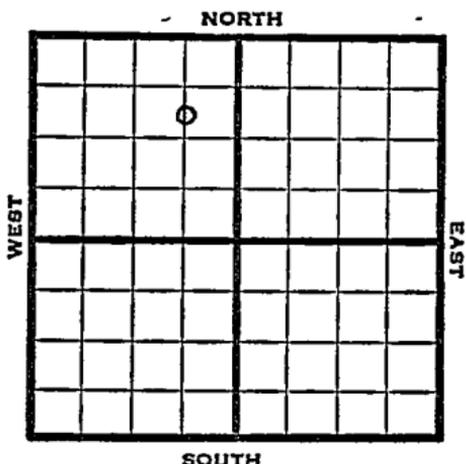

1952

Elev. 1413' REPORT

1/23

Spud 1-18-52
8" @ 195'
Drlg. 1205'

2/6

Br Li 2854 Lans. 2909
DST 3281-3302 1 hr 160' md & GCSW
& 540' SCSW 1385# bhp
Miss 3714
DST 3749-67 1 hr 3120' gassy oil
12' SW 1125# BHP
TD 3767 5" @ 3762

2/13

DP to 3767' TD
F 20 BOPH for 8 hrs. 27/64" TC

2/20
2/27

NR
Spud 1-18-52
Oil Well TD 3767
8" @ 195 Br Lime 2854
Lans. 2909
DST 3281-3302 opn 1 hr. Rec. 160' md
& gcsw 540' gcsw Miss 3714
DST 3749-67 opn 1 hr. Rec. 3120'
gassy oil 12' sw TD 3767
5" @ 3762 TD 3767
Comp. BHB 1442 bopd

COMPLETED


County Sedgwick State Kansas

Sec. 6 (Blk. 28 (Sur. 4W (Twp.) (Rge.) Map No.

Operator Westgate Greenland

Well No. 3 Farm Davis (B)

Elev. _____ Location C S/2 NE NW

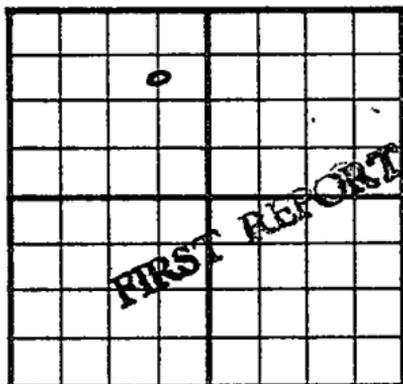

990 Ft. From N Line NW

660 Ft. From E Line Quarter

Ist. Report JAN 23 1952

Completion _____

Remarks _____

Spudding Date 1-18-52

Drlg. Data _____ Barthlemew

8" @ 195' Drlg. 1205

J. E. TYRA

