


Section 6 Township 28 Range 4 W

Well No. # 2 Davis (B)

Company Westgate Greenland

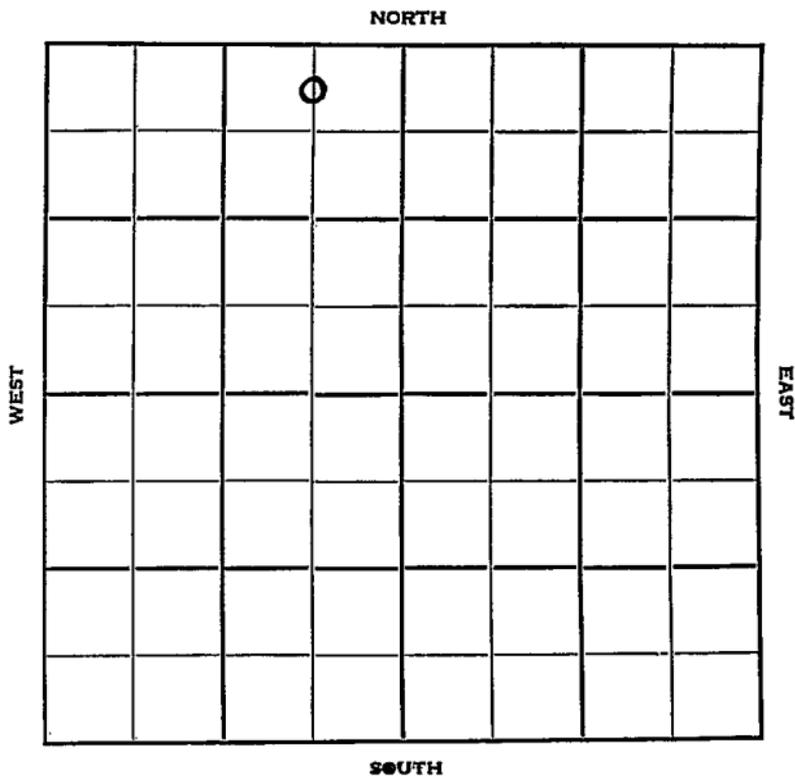

Sec. 6 Twp. 28 R. 4W

Well No. #2 Davis (B) Farm

Westgate Greenland Company

Barthelomew Contractor


330' Ft. from N. Line

_____ Ft. from S. Line

660' Ft. from E. Line

_____ Ft. from W. Line

C N/2 NE NW

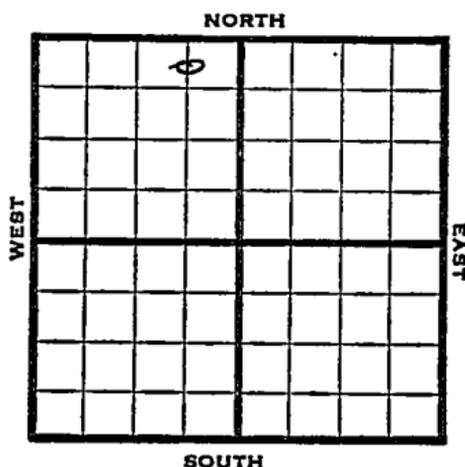

1951 Elev. 1417' REPORT

12/19

Spud 12-13-51

8" @ 198

Drlg. 2483'

1952

1/30

Spud 12-13-51

Oil Well TD 3783

8" @ 198

Br Lime 2845 Lans. 2895

Miss 3711 Dol. 3747

DST 3749-58 opn 1 hr.

Rec. 180' gcm 120' oil 5' sw

DST 3759-83 opn 1 hr. Rec. 90' vsocm

TD 3783 5" @ 3782

70/3745-60 1 boph 1000 A F/58 boph

1st hr. 38 boph 2nd hr. 28 bopd 3rd

hr. Comp. 277 bopd 12% wtr.

COMPLETED


County Sedgwick State Kansas

Sec. 6 (Blk. 28) (Sur. 4W) (Twp.) (Rge.) Map No.

Operator Westgate Greenland

Well No. 2 Farm Davis (B)

Elev. _____ Location C N/2 NE NW

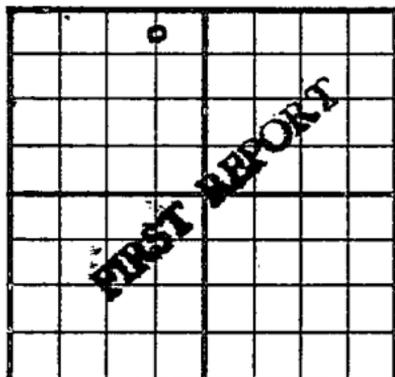

330 Ft. From N Line NW

660 Ft. From E Line Quarter

1st. Report DEC 1 9 1951

Completion _____

Remarks _____

Spudding Date 12-13-51

Drlg. Data Barthelomew

8" @ 198 Drlg. 2483

J. E. TYRA

