
FORM 51 25M 8-50 WESTERN Sedgwick KANSAS

Section 6 Township 28 Range 4W

Well No. #1 Davis "B"

Company Westgate-Greenland

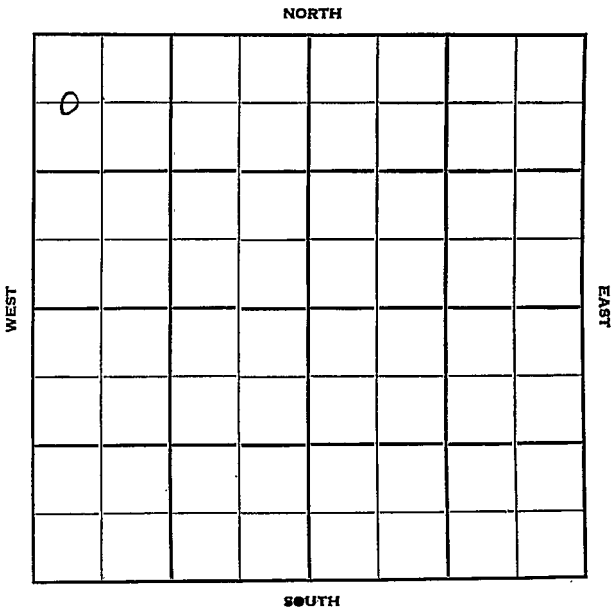

FORM 252-B
10M 10-50 PETROL

Sedgwick

Sec. 6 Twp. 28 R. 4W KANSAS ✓

Well No. #1 Davis "B" Farm

Westgate-Greenland Company

Jackson Drlg. - Contr. Contractor

Bartholomew Pool


660' Ft. from N. Line

Ft. from S. Line

Ft. from E. Line

330' Ft. from W. Line

C W L NW NW

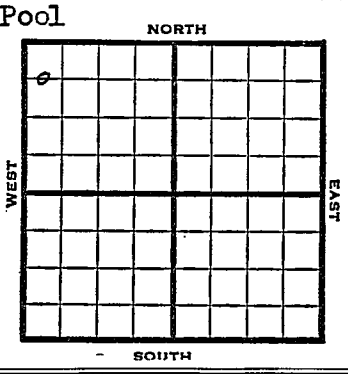

1950	Elev. 1419' REPORT
12/6	Spud 12-1-50 8" @ 195' Drlg. 1805'
1951 2/21	Spud 12-1-50 Oil Well TD 3782 8" @ 195 KC 2911-19 Miss Chat 3722 Miss dol. 3757 Cored 3758-64 Rec. 6' dol. DST 3759-82 opn 1 hr Rec. 120' o& gcm TD 2782 5" @ 3749 1000 A Comp. 22 bopd 60% wtr. COMPLETED

FORM 275 FOR SALE BY KANSAS BLUE PRINT CO.


County Sedgwick State Kansas

Sec. 6 (Blk. Twp.) 28 (Sur. Rge.) 4W Map No.

Operator Westgate-Greenland

Well No. 1 Farm Davis "B"

Elev. Location C W I. NW NW

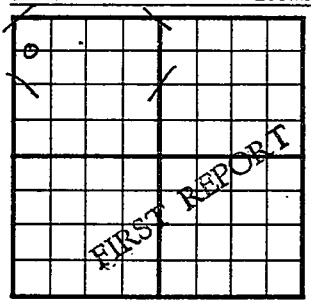

660 Ft. From N Line NW

330 Ft. From W Line Quarter

1st. Report DEC 6 1950

Completion

Remarks

Jackson Drlg. - Contr.

Spudding Date 12-1-50

Drlg. Data Bartholomew Pool

8" @ 195 drlg. 1805

J. E. TYRA

FORM 275 FOR SALE BY KANSAS BLUE PRINT CO.


County Sedgwick State Kansas

Sec. 6 (Blk. Twp.) 28 (Sur. Rge.) 4W Map No.

Operator Westgate-Greenland

Well No. 1 Farm Davis "B"

Elev. 1419 Location C W L NW NW

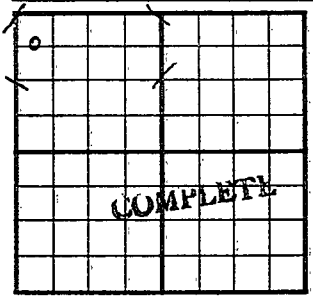

660 Ft. From N Line NW

330 Ft. From W Line Quarter

1st. Report

Completion FEB 21 1951

Remarks Bartholomew Pool

Jackson Drlg. - Contr.

Spudding Date 12-1-50

Drlg. Data Oil well TD 3782

8" @ 195 KC 2911-19 Miss. chat 3722

Miss. dol. 3757 Cored 3758-64 Rec. 6' dol.

DST 3759-82 open 1 hr. Rec. 120' o & gcm

TD 3782 5" @ 3749 1000 A

Comp. 22 bopd 60% water

J. E. TYDA