

Sedgwick

Map No. Sec. 6 Twp. 28 R. 1^W


Well No. 1 Jordan Farm
Lamb Shoreline Company

 Ft. from N. Line

990' Ft. from S. Line

 Ft. from E. Line

330' Ft. from W. Line

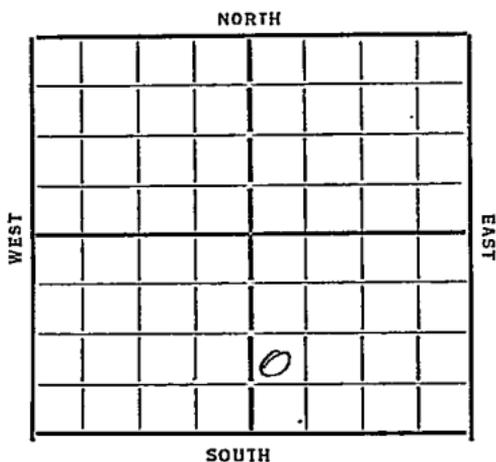

Date 1934

REPORT

O. W. D. D

Date	Location	Flow	Notes
1/10	Location		
1/17	Rig		
1/24	—		
1/31	Drly 165	20"	134
2/4	" 685		
2/17	" 1535	5"	886
2/23	" 1915	12"	1547
3/1	" 2295	217 7/8	2004-14
	10" at 2095		
3/8	Drly 2900	2002	2790
3/19	Top Simpson	3652	
	T.D. 3652	mkg 40 to	75 bbls per hour
3/22	B.L. 3580	9 1/2 hrs	3652
	95 3652 1/2	flowed in 20 min	
3/29	Flowed 121	Bbls 1st hr	
	and 114	2nd hr	Flow 44.3
	Corrected.	(Telegram)	
3/30	Flowed 1179	bbls 17 hrs	
	Quit flowing	between 3	
	& 4 o'clock	this morning	
	Hole may be bridged	(Telegram)	

4/9 Flowing 70 Bbls hr
Shut in to 190 Bbls day

4/12 40 Bbls per hr 85% water

4/19 —

4/25 Nileox 3652 TD 3652 1/2
150 oil 1850 water

COMPLETED

1935

O. W. D. D

6/19 OT 7 3652 1/2

5" 3668

Simpson 3674

T 7 3698

J. A.

FIRST REPORT

↓

ABANDONED

Map No. 38 Sec. 6 Twp. 28 R. 1W

Well No. 1 - Jordan

Jank & Shoreline Oil Company

Contractor

FIRST REPORTS

SECTION PLAT

..... Ft. from N. Line

990 Ft. from S. Line

..... Ft. from E. Line

330 Ft. from W. Line

		o	

Location V

Rig up

Drilling and Remarks:

RECORD

Cased.....in.,ft.

Sand.....

Gas.....

Oil.....

Total Depth.....

PRODUCTION

1st 24 hrs. Nat.....

1st 24 hrs. after shot.....

Gas.....Cu. Ft.


Dry Hole.....

Abandoned.....

Date

1-10-34 1934 C. Y. Mannschreck Scout

no survey

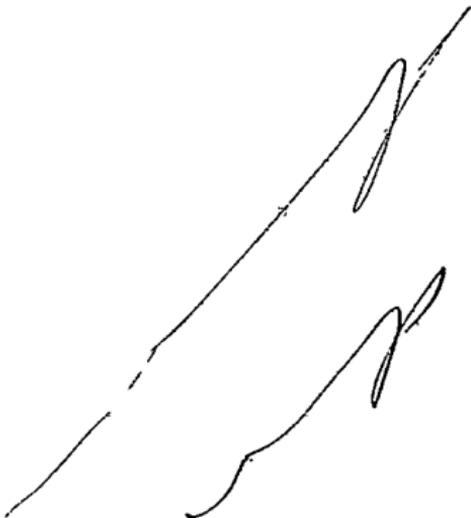


Returned	
Calls	MAB
Tax	CRS
France Map	X
Scarborough Map	X
Moody Map	X
Scarborough Plat Book	
Moody Plat Book	

Map No. 38 Sec. 6 Twp. 28 R. 1W

Well No. 1 - Gordon

Lank & Shoreline Company

Contractor

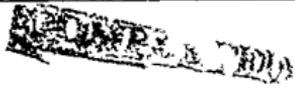

SECTION PLAT

		0	

_____ Ft. from N. Line

990 Ft. from S. Line

_____ Ft. from E. Line

330 Ft. from W. Line

Location _____

Rig up _____

Drilling and Remarks:

150 oil
1850 water

RECORD

Cased _____ in., _____ ft.

Sand Milcof 3652

Gas _____

Oil _____

Total Depth 3652 1/2

PRODUCTION

1st 24 hrs. Nat. _____

1st 24 hrs. after shot _____

Gas _____ Cu. Ft.

Dry Hole _____

Abandoned _____

Date

4-25-34 19

DRY HOLE CHECK

Scout

no small map

Returned
Cards	<i>PH</i>
Tracing	<i>CRD</i>
France Map	<i>[Signature]</i>
Scarborough Map	<i>[Signature]</i>
Moody Map	<i>[Signature]</i>
Scarboro. Plat Book
Moody Plat Book

Map No. 38 Sec. 6 Twp. 28 R. 1W

Well No. 1 - Jordan

Lank et al

Company

Contractor

1st Sep
+
Comp.

SECTION PLAT

		10	

Ft. from N. Line

990 Ft. from S. Line

Ft. from E. Line

330 Ft. from W. Line

Owned

Location

Rig up

Drilling and Remarks:

OTN 3652 1/2

5" 3668

Amperon 3674

TD 3698

10 + 17

RECORD

Cased in., ft.

Sand

Gas

Oil

Total Depth

PRODUCTION

1st 24 hrs. Nat.

1st 24 hrs. after shot

Gas Cu. Ft.

Dry Hole

Abandoned

Date

SRVAL MANNSCHRECK

6-19-35 192

Scout

no small map

Returned	<input checked="" type="checkbox"/>
Cards	<input checked="" type="checkbox"/>
Tracing	<input checked="" type="checkbox"/>
France Map	<input checked="" type="checkbox"/>
