


Section 6 Township 28 Range 34-~~4~~

Well No. #1 Taton

Company Stanolind

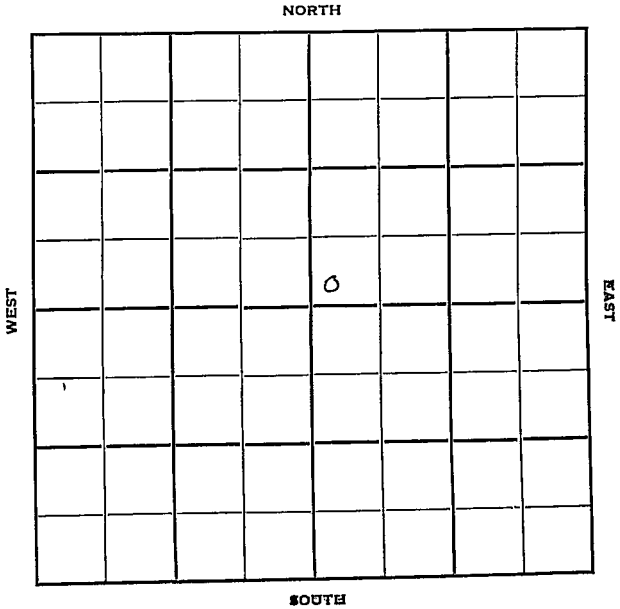

Haskell

Sec. 6 Twp. 28 R. 34W ✓

Well No. #1 Taton Farm _____

Stanolind Company _____

Contractor _____

Hugoton Pool


_____ Ft. from N. Line

150' Ft. from S. Line

_____ Ft. from E. Line

150' Ft. from W. Line

SW NE

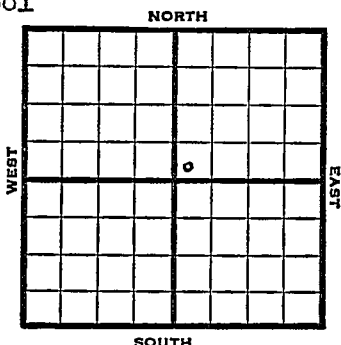

1950

Elev 3088' REPORT

10/25

Location

12/13

Spud 11-15-50

10" @ 838

Her 2649

Win 2716

Ft. Riley 2765

7" @ 2860

TD 2860

84/2656-70 80/2676-86 78/2719-32

210/2765-2800

22900 total acid

Comp 14,300,000 gas

400#

Completed

COMPLETED

County Haskell State Kansas

Sec. 6 (Bk.) 28 (Sur.) 34W Map No.

Operator Stanolind

Well No. 1 Farm Taton

Elev. 3088 Location SW NE

COMPLETE

150 Ft. From S Line NE

150 Ft. From W Line Quarter

Ist. Report

Completion DEC 13 1950

Remarks Hugoton Pool

Spudding Date 11-15-50

Drig. Data Gas well TD 2860

10" @ 838 Her. 2649 Win. 2716

Ft. Riley 2765 7" @ 2860 TD 2860

84/ 2656-70 60/ 2676-86 78/ 2719-32

210/ 2765-2800 22000 total acid

Comp. 14,300,000 gas 400#

J. E. TYRA