

KANSAS


Grant county

FORM 51 5M 6-46 PETROL

Section 6 Township 28 Range 35-W

Well No. #1, Cooper

Company Columbian Fuel

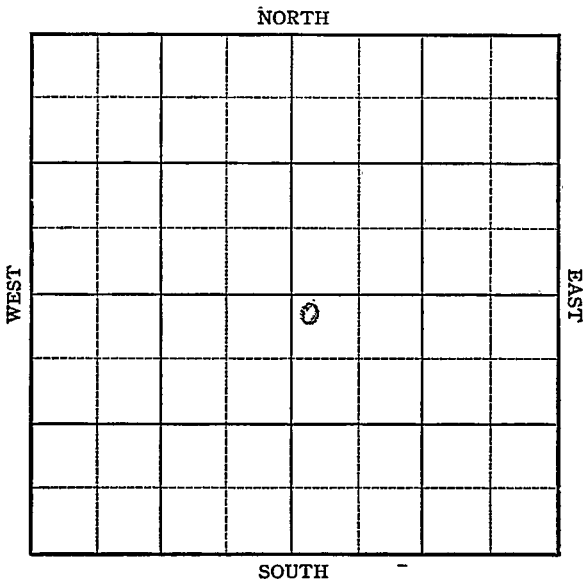

KANSAS

Grant County

Sec. 6 Twp. 28 R. 35W

Well No. #1 Cooper Farm

Columbian Fuel Company

Hugoton


100 Ft. from N. Line

 Ft. from S. Line

 Ft. from E. Line

100 Ft. from W. Line

NW SE

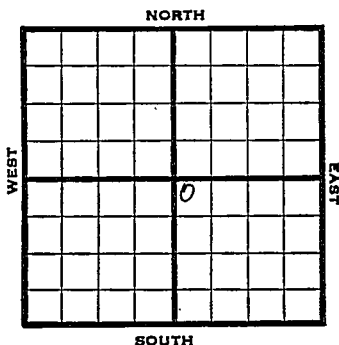

1946

Elev. 3118' REPORT

6/5

Location

6/12

10" @ 507 WOC

6/18

TD 2597-7" @ 2589' RUST

6/26

Drlg 2624'

7/3

TD 2887'

202' of 5" Perf liner @ 2887'

7/9

TD 2887'

7/16

"

7/23

"

7/30

"

8/6

15000 acid

8/13

" "

8/20

" "

8/27

" "

9/5

" "

9/10

" "

9/18

7" @ 2589'

202' of 5" Perf liner @ 2787'

Acid 15,000

Gas 16,272,000

TD 2787'

RPR 411#

COMPLETED

Kansas Pool Name Hugoton**KANSAS**Map No. 10000 Sec. 6 Twp. 28 R. 35WWell No. 1 CooperColumbian Fuel

Company

FIRST REPORT

Contractor

NW SE

SECTION PLAT100 Ft. from N. Line Ft. from S. Line Ft. from E. Line100 Ft. from W. Line

		6	

Grant CountyLocation XRig up

Drilling and Remarks:

RECORDCased in., ft.Sand Gas Oil Total Depth **PRODUCTION**1st 24 hrs. Nat. 1st 24 hrs. after shot Gas Cu. Ft.Dry Hole Abandoned

Date

JUN 5 1946 19 S. J. LEWIS Scout

KANSAS

Kansas

Pool Name Hugoton PoolMap No. _____ Sec. 6 Twp. 28 R. 35WWell No. 1 CooperColumbian Fuel

Company

COMPLETED


Contractor

NW SE

E13118
SECTION PLAT100 Ft. from N. Line

Ft. from S. Line

Ft. from E. Line

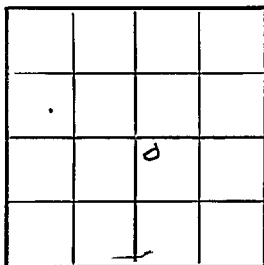100 Ft. from W. LineGrant County

Location _____

Rig up _____

Drilling and Remarks:

7" 02589302' of 5" Pipe / line0258915000 acid16,272,000 Gas411 # R₂

RECORD

Cased _____ in. _____ ft.

Sand _____

Gas _____

Oil _____

Total Depth 2787

PRODUCTION

1st 24 hrs. Nat. _____

1st 24 hrs. after shot _____

Gas _____ Cu. Ft.

Dry Hole _____

Abandoned _____

Date

SEP 1 8 1946 19S. J. LEWIS

Scout