

Section 6 Township 28 Range 31W

Well No. #1 Fleming

Company Cities Service

NORTH

			0				

WEST

EAST

SOUTH

Sec. 6 Twp. _____ R. _____

Well No. #1 Fleming Farm _____

Cities Service Company _____

Contractor _____


Wildcat

100 Ft. from N. Line

_____ Ft. from S. Line

100 Ft. from E. Line

_____ Ft. from W. Line

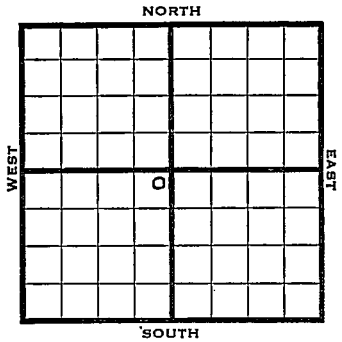

NE SW

MCPG Acreage in twp

1950

Elev 2893 REPORT

10/18 Location

11/8 Spud 10-18-50

8" @ 640

Her 2734

Krider 2762

Win 2827

TD 2865

D&A

ABANDONED

