

DX 78-1


Pratt

KANSAS

Section 6 Township 28 Range 13W

Well No. #1 Fannie "A"

Company Phillips Pet.

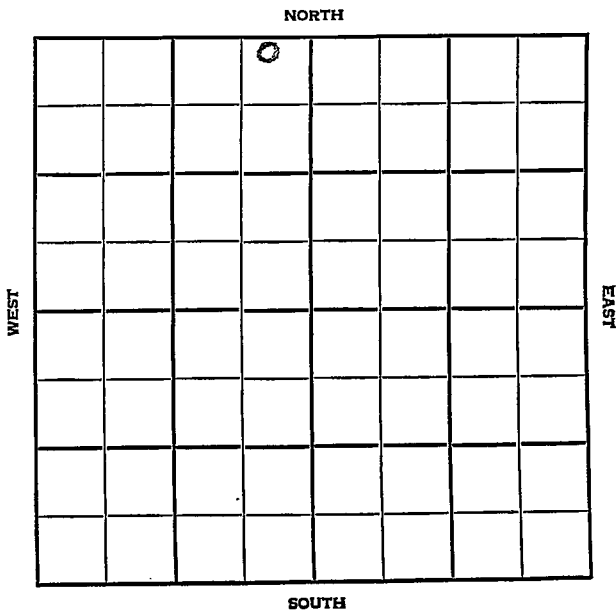

Pratt

KANSAS


SEC.	6	TWP.	28	R.	13W
------	---	------	----	----	-----

WELL NO.
1 Fannin "A" FARM

COMPANY
Phillips Pet

CONTRACTOR
**Co. Tools
 S. Fitzsimmons**

_____ Ft. from N. Line
 _____ Ft. from S. Line
 _____ Ft. from E. Line
 _____ Ft. from W. Line

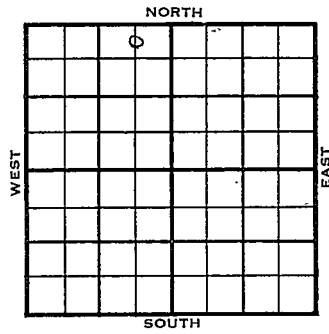

C
~~B~~ N $\frac{1}{2}$ NE NW

	ELEVATION	REPORT
1955	1916	

5/26 Location

7/27 Comm 5-24-55
 Anh Elm 3056, Tp 3301, H 3654,
 Tr 3679, B1 3809, L 3828, BKC 4183,
 M 4288, V chtg 4331, sh 4375,
 Sd 4392, A 4506,
 TD 4522,
 9 5/8" @ 450/285 7" @ 4517/175
 CO to 4489 28/4410-17 B/1/2 gwph
 2 hr 52/4393-4406 B/1/2 gwph 12 hr
 sd-frac S/115 bo 3 hr P & F 40 bo
 114 bw 24 hr Comp 40 bopd 60% wtr.

COMPLETED

County Pratt Elev. 1916
 Sec. 6 Twp. 28 Rge. 13W
 Company Phillips Pet.
 Farm Name Fannie "A" No. 1

TOPS	DEPTH	LOG	DATUM
Anb. <u>51m</u>	<u>3056</u>		<u>1140</u>
Tr.	<u>3201</u>		<u>1385</u>
H.	<u>3654</u>		<u>1738</u>
Tr.	<u>3674</u>		<u>1753</u>
Dg.			
BL.	<u>3809</u>		<u>1893</u>
L.	<u>3828</u>		<u>1912</u>
K.C.			
B.K.C.	<u>4183</u>		<u>2267</u>
Ce.			
C.			
M.	<u>4288</u>		<u>2372</u>
M.			
K.			
Mz.			
Ma.			
V. <u>Ch</u>	<u>4321</u>		<u>2415</u>
S. <u>sb</u>	<u>4375</u>		<u>2479</u>
S. <u>sd</u>	<u>4393</u>		<u>2476</u>
A.	<u>4500</u>		<u>2590</u>
R.			
PE.			
G.			
T.D.	<u>4522</u>		

Loc. in Sec. _____
C N $\frac{1}{2}$ NE NW
 Geol. _____
 Contr. _____
 Co. tools _____
 Pool _____
S. Fitzsimmons

COMPLETE

Date Comm. 5-24-55 JUL 27 1955

9 5/8" @ 450/285 7" @ 4517/175

CO to 4489 28/ 4410-17 B/ $\frac{1}{2}$ gwph

2 hr. 52/ 4393-4406 B/ $\frac{1}{2}$ gwph 12 hr.

sd-frac S/ 115 bo 3 hr. P & F/ 40 bo

114 bw 24 hr. Comp. 40 bopd 60% wtr.

Co.
 Use.
 No.
 Sec.
 T.
 R.