


Section 6 Township 28 Range 11W

Well No. 1 Bucklin

Company G-M-R Oil

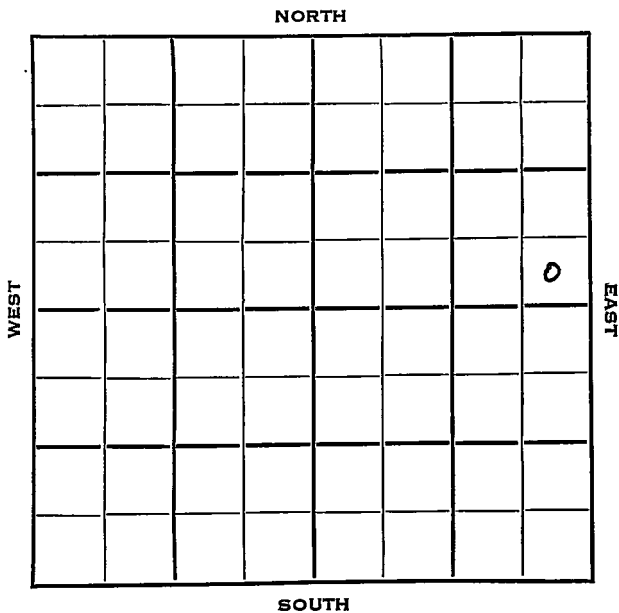

# LOT FILE Pratt KANSAS

SEQ. 6      28      R. 11 W

WELL NO.

#1 Bucklin

FARM

COMPANY

G-M-R Oil

CONTRACTOR

G-M-R Oil


Wildcat

\_\_\_\_\_ Ft. from N. Line

330 \_\_\_\_\_ Ft. from S. Line

330 \_\_\_\_\_ Ft. from E. Line

\_\_\_\_\_ Ft. from W. Line

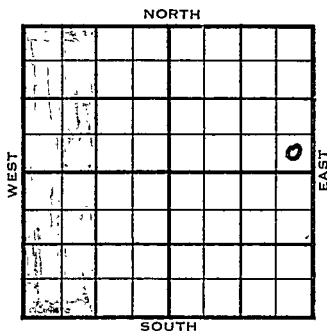

SE SE NE

MCPC has  $W\frac{1}{2}$   $W\frac{1}{2}$  of 6

1953	ELEVATION	REPORT
	1750'	
11/4	Spud 10-30-53 8" @ 250 Drlg. 1816'	
11/12	Lost hole. D & A 90' west. Set. 13" @ 175	Skid rig WOC (Ltr-McG)
11/11	Spud 10-30-53 8" @ 250' TD 2974' Lost circ. D&A	
<b>ABANDONED.</b>		



Scout Cards *mm*

Land Small Map

Land Wall Map *53*

Tracings

France Map

Pierce Map

NOV

9

NOV

Prig. Data



Nov 16 1953

Scout Cards	40
Land Small Map	
Land Wall Map	3
Tracings	
France Map	
Pierce Map	
Misc.	

Orig. Data