


Section 6 Township 28 Range 11W

Well No. 1-A Bucklin

Company G-M-R Oil

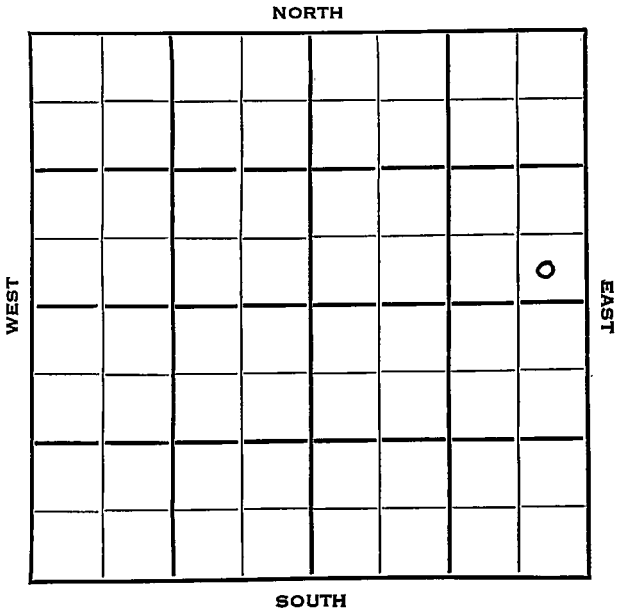

HOT FILE

Pratt

KANSAS

SEC. 6	TWP. 28	R. 11W ✓
--------	---------	----------

WELL NO.

#1-A Bucklin

FARM

COMPANY

G-M-R Oil

CONTRACTOR

G-M-R
Wildcat

Ft. from N. Line


330

Ft. from S. Line

420

Ft. from E. Line

Ft. from W. Line

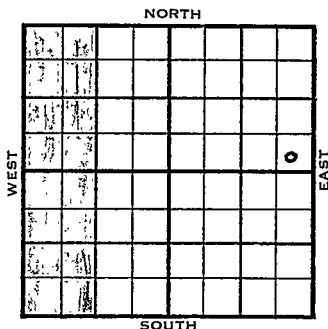SE SE NE (Twin to
lost hole)

1953	ELEVATION	REPORT
11/11	Spud 11-9-53 13" @ 175' WOC	
11/12	Lost hole	XXXXXXXXXXXXXXXXXXXX
	XXXXXXXXXXXXXXXXXXXX	XXXXXXXXXXXXXXXXXXXX
	XXXXXXXXXXXXXXXXXXXX	XXXXXXXXXXXXXXXXXXXX
11/18	Drlg 3255'	
12/9	Heeb 3432', Doug 3460', Br li 3611', Lans 3630', Miss 4095', KH 4185', V 4291' DST 4298-4318', 1 hr., 880' oil, 30' M, 1210# DST 4322-42', 3/4 hrs., 35' M, 1200# Simp 4390', Arb. 4496' RTD 4508' 5" @ 4370' CO 4350'	
12/16	12/4314-18 B/ 2 boph 10% wtr. 500 A S/ 33 boph / 15 bwph 2 hrs POP	

OVER

1954
1/6

Spud 11-9-53

Oil Well

TD 4508'

13" @ 175'

Heeb 3432', Doug 3460', Br lime
3611, Lans 3630', Miss 4095', Kh.
4185', Viola 4291'

DST 4298-4318', opn 1 hr., gas in
12 mins., rec. 880' oil, 30' mud,
1210#

DST 4322-42', opn 45 mins., rec. 35'
mud, 1200#

Simp. 4390', Arb. 4496'

TD 4508'

5" @ 4370'

CO to 4350'

12/4314-18, B/2 boph 10% wtr.
500A

s/33 boph 15 bw

P/183 bo 33 bw

P&F/117 bo 52 bw 15 hrs.

P&F/213 bo 22 bw 24 hrs.

Comp. 195 bopd 4% wtr.

COMPLETED

NOV 12 1953

Scout Cards

Small Map

Land Use Map

Drawings


Boat Map

Force Map

Misc.

Orig. Data

County Pratt State Kansas
 Sec. 6 (Blk. Twp.) 28 (Sur. Rge.) 11W Map No.
 Operator G-M-R Oil
 Well No. 1-A Farm Bucklin
 Elev. Location SE SE NE (twin)

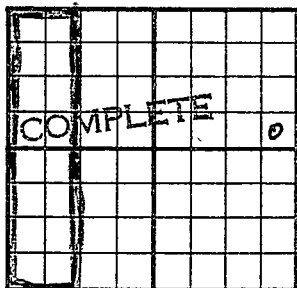

330 Ft. From S Line NE
420 Ft. From E Line Quarter

1st. Report

Completion JAN 6 1954

Remarks Wildcat

G-M-R - Contr.

Spudding Date 11-9-53

Drilg. Data Oil well TD 4508

13" @ 175 Heeb. 3432 Doug. 3460

Br. lime 3611 Lans. 3630 Miss. 4095

Kh. 4185 Viola 4291 DST 4298-4318

open 1 hr. gas in 12 min. Rec. 880' oil

30' mud 1210# DST 4322-42 open 45 min.

Rec. 35' mud 1200# Simp. 4390

Arb. 4496 TD 4508 5" @ 4370 CO to 4350

12/ 4314-18 B/ 2 boph 10% wtr.

500' A S/ 33 boph 15 bw P/ 183 bo

33 bw -P & F/ 117 bo 52 bw 15 hr.

P & F/ 213 bo 22 bw 24 hr.

Comp. 195 bopd 4% wtr.

J. G. McGEHEE

JAN 12 1934

Scout Cards	GP
Land Small Map	
Land Wall Map	
Tracings	
France Map	
Pierce Map	
Misc.	

Dirg. Bala