

KANSAS

Sedgwick County

FORM 51 IOM 12-46 PETROL

Section 7 Township 28 Range 1-W

Well No. 1 Wolf


Company Aladdin Pet.

No name

NORTH

WEST

EAST

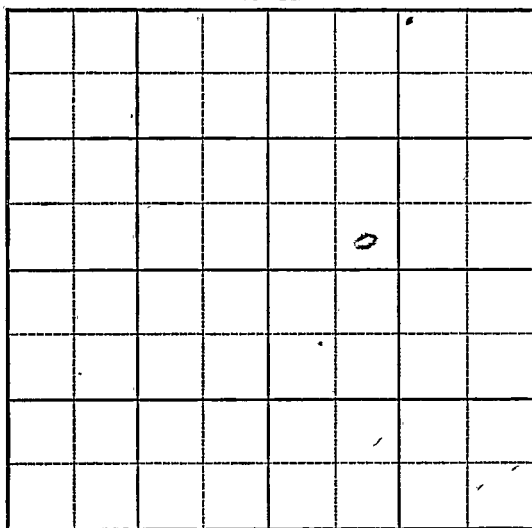

SOUTH

KANSAS

Sedgwick County

Sec. 7 Twp. 28 R. 1-W

Well No. 1 Wolf Farm

Aladdin Pet. Company


No Name

 Ft. from N. Line

330 Ft. from S. Line

 Ft. from E. Line

990 Ft. from W. Line

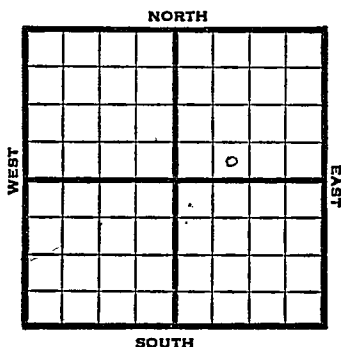

SE SW NE
r

1947	Elev.	REPORT	1339'
7-16	Loc.		
7/22	8" @ 160 Drlg. 1670		
7/28	Kansas City 2776' Drlg 3180'		
8/6	Simpson 3662' 5" @ 3663' TD 3666' 2000' oil		
8/13	"		
8/20	Fow 5 bbls oil PH		
8/27	Simp. 3662' 5" @ 3663' Bonus Pot 3000 Total Depth 3666'		
	COMPLETED		

Map No. 38 Sec. 7 Twp. 28 R. 1W

Well No. 1 Wolf

Aladdin Pet.

Company

COMPLETE

Contractor

SE SWNE

E1, 1889
SECTION PLAT

 Ft. from N. Line

330 Ft. from S. Line

 Ft. from E. Line

990 Ft. from W. Line

Sedgwick County

Location

Rig up

Drilling and Remarks:

Dring 3662

5 C 3663

Born 12 1800

412 1/2

RECORD

Cased in., ft.

Sand

Gas

Oil

Total Depth 2666

PRODUCTION

1st 24 hrs. Nat.

1st 24 hrs. after shot

Gas Cu. Ft.

Dry Hole

Abandoned

Date

AUG 27 1947 19

S. J. LEWIS

Scout

Map No. _____ Sec. 7 Twp. 28 R. 1W

Well No. 1 Wolf

Aladdin Pet. Company

FIRST REPORT Contractor

SE SW NE


SECTION PLAT

_____ Ft. from N. Line

330 Ft. from S. Line

_____ Ft. from E. Line

990 Ft. from W. Line

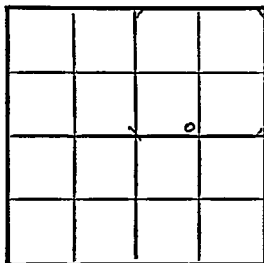

Sedgwick County

Location X

Rig up _____

Drilling and Remarks:

RECORD

Cased _____ in., _____ ft.

Sand _____

Gas _____

Oil _____

Total Depth _____

PRODUCTION

1st 24 hrs. Nat. _____

1st 24 hrs. after shot _____

Gas _____ Cu. Ft.

Dry Hole _____

Abandoned _____

Date

JUL 16 1947 19

S. J. LEWIS Scout