

Section 7 Township 28 Range 5WWell No. #1 ClouseCompany Westgate-Greenland

NORTH

							0

WEST

EAST

SOUTH

Kingman KANSAS

Sec. 7 Twp. 28 R. 5W

Well No. #1 Clouse Farm

Westgate-Greenland Company

Jackson Drlg.-Contr. Contractor

Dewey Pool

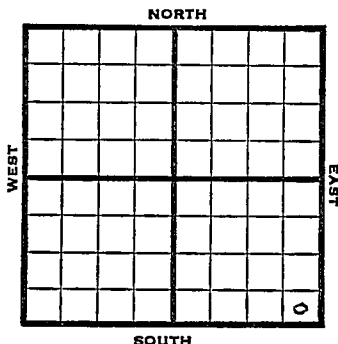
 Ft. from N. Line

330' Ft. from S. Line

330' Ft. from E. Line

 Ft. from W. Line

SE SE SE



1950

Elev 1417'

REPORT

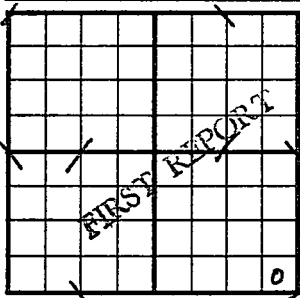
12/27

Spud 12-22-50
8" @ 205'
WOC

1951
1/10

Spud 12-22-50
8" @ 205
KC 2985 Miss 3764
Dol 3804
DST 3804-17 opn 1 hr rec 145' water
TD 3841
D&A

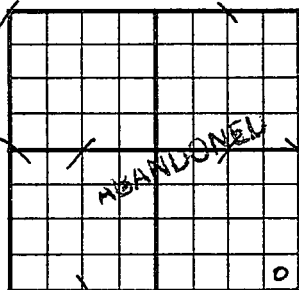
ABANDONED

County Kingman State KansasSec. 7 (Blk.) 28 (Sur.) 5W Map No.Operator Westgate-GreenlandWell No. 1 Farm ClouseElev. Location SE SE SE330 Ft. From S Line SE330 Ft. From E Line Quarter1st. Report DEC 27 1950

Completion

Remarks

Jackson Drlg. - Contr.Spudding Date 12-22-50Drlg. Data Dewey Pool8" @ 205 WOC

County Kingman State KansasSec. 7 (Blk.) 28 (Sur.) 5W Map No.Operator Westgate-GreenlandWell No. 1 Farm ClouseElev. 1417 Location SE SE SE330 Ft. From S Line SE330 Ft. From E Line Quarter1st. ReportCompletion JAN 10 1951Remarks Dewey PoolJackson Drlg. - Contr.Spudding Date 12-22-50Drlg. Data D & A TD 38418" @ 205 KC 2985 Miss. 3764Dol. 3804 DST 3804-17 open 1 hr.Rec. 145' water TD 3841D & A

J. E. TYRA