
FORM 51 IOM 12-46 PETRO KANSAS Grant county

Section 7 Township 28 Range 37-W

Well No. #1 Gall

Company Stanolind

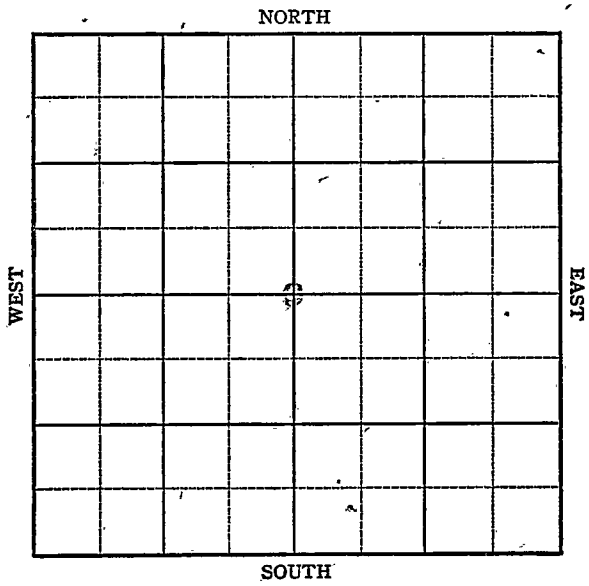

FORM 252-A
5M 12-45 PETROL

KANSAS Grant

Sec. 7 Twp. 28 R. 37-W

Well No. #1 Gall Farm

Stanolind Company

Hugoton Pool


2640 Ft. from N. Line

Ft. from S. Line

2640 Ft. from E. Line

Ft. from W. Line

C Sec.

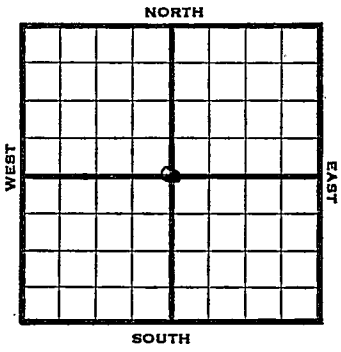

REPORT

1947 Elev. 3063

1/29 Location

2/5 "

2/12 8" @ 605'
Drlg 1955'

2/19 TD 2585'
5" @ 2540'
3000 Acid
Plug 2525

2/26 5" @ 2540
Perf
16,000 Acid
5,893,000 Gas
345# R Pr
TD 2585'

COMPLETED

Form 26 200 Bks. 10-46 Petrol Kansas KANSAS Hugoton Pool

Map No. ____ Sec. 7 Twp. 28 R. 37W


Well No. 1 Gall

Stanolind Company

FIRST REPORT Contractor

C Sec.

SECTION PLAT

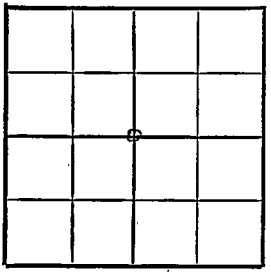

2640 Ft. from N. Line

____ Ft. from S. Line

2640 Ft. from E. Line

____ Ft. from W. Line

Grant County

Location X

Rig up

Drilling and Remarks:

RECORD

Cased ____ in., ____ ft.

Sand

Gas

Oil

Total Depth

PRODUCTION

1st 24 hrs. Nat.

1st 24 hrs. after shot

Gas ____ Cu. Ft.

Dry Hole

Abandoned

Date

JAN 2 9 1947 19 S. J. LEWIS Scout

Form 26 200 Bks. 10-46 Petrol KANSAS Kansas

Hugoton Pool

Map No. _____ Sec. 7 Twp. 28 R. 37W

Well No. 1 Gall


Stanolind Company

COMPLETE Contractor

C Sec.

E 13968

SECTION PLAT

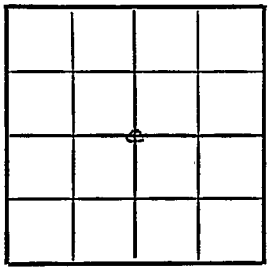

2640 Ft. from N. Line

_____ Ft. from S. Line

2640 Ft. from E. Line

_____ Ft. from W. Line

Grant County

Location _____

Rig up _____

Drilling and Remarks:

5'C 2570

Perf.

1600 acid

5,833,000 Gas

845# RP

RECORD

Cased _____ in., _____ ft.

Sand _____

Gas _____

Oil _____

Total Depth 2585

PRODUCTION

1st 24 hrs. Nat. _____

1st 24 hrs. after shot _____

Gas _____ Cu. Ft.

Dry Hole _____

Abandoned _____

Date

FEB 26 1947 19

S. J. LEWIS Scout