

KANSAS


FORM 51 5M 6-46 PETROL

Grant county

Section 7 Township 28 Range 38-W

Well No. #1, Myers

Company Stanolind Oil and Gas Company

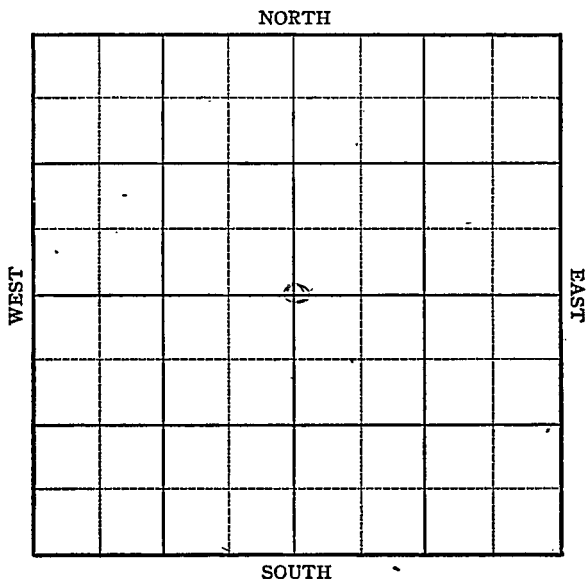

KANSAS

Grant ✓

Sec. 7 Twp. 28 R. 38W

Well No. 1 Myers Farm

Stanolind

Company

Hugoton


2640 Ft. from N. Line

_____ Ft. from S. Line

2640 Ft. from E. Line

_____ Ft. from W. Line

C Sec.

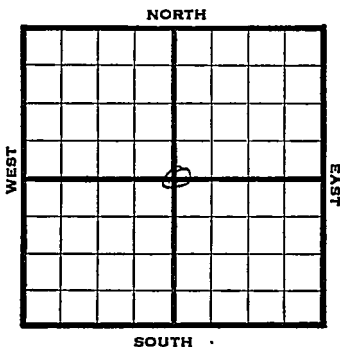

1946

Elev. 3132'

REPORT

11/13 8" @ 639'
Drlg 645'
11/20 1668 fsg
11/27 " "
12/3 " "
12/11 6" @ 2493'
TD 2540'
Perf
18500 Acid
6,680,000 Gas

COMPLETED

Map No. _____ Sec. 7 Twp. 28 R. 38W

Well No. 1 Myers

Stanolind Company

FIRST REPORT

Contractor

C Sec.


SECTION PLAT

2640 Ft. from N. Line

_____ Ft. from S. Line

2640 Ft. from E. Line

_____ Ft. from W. Line

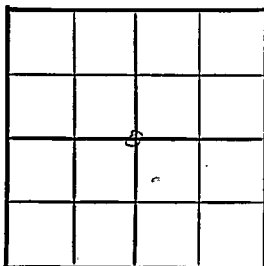

Grant County

Location _____

Rig up _____

Drilling and Remarks: _____

8" @ 639

drlg. 645

RECORD

Cased _____ in., _____ ft.

Sand _____

Gas _____

Oil _____

Total Depth _____

PRODUCTION

1st 24 hrs. Nat. _____

1st 24 hrs. after shot _____

Gas _____ Cu. Ft.

Dry Hole _____

Abandoned _____

Date

NOV 13 1946

19

S. J. LEWIS

Scout

Map No. _____ Sec. 7 Twp. 28 R. 38W

Well No. 1 Myers

Stanolind Company
COMPLETED

C Sec.

Contractor
E. J. B. B.
SECTION PLAT


2640 Ft. from N. Line

_____ Ft. from S. Line

2640 Ft. from E. Line

_____ Ft. from W. Line

Grant County

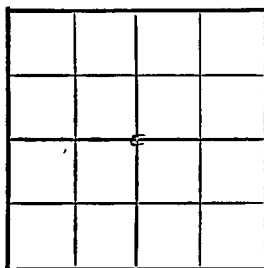

Location _____

Rig up _____

Drilling and Remarks:

6" @ 2498
Prof.
18000 acal
6,680,000 Gas

RECORD

Cased _____ in., _____ ft.

Sand _____

Gas _____

Oil _____

Total Depth 2540

PRODUCTION

1st 24 hrs. Nat. _____

1st 24 hrs. after shot _____

Gas _____ Cu. Ft.

Dry Hole _____

Abandoned _____

Date

DEC 1 1 1946 19

S. J. LEWIS Scout