


Section 7 Township 28 Range 32W  
Well No. #1 E. A. Cox "B"  
Company National Assoc. Pet.

NORTH

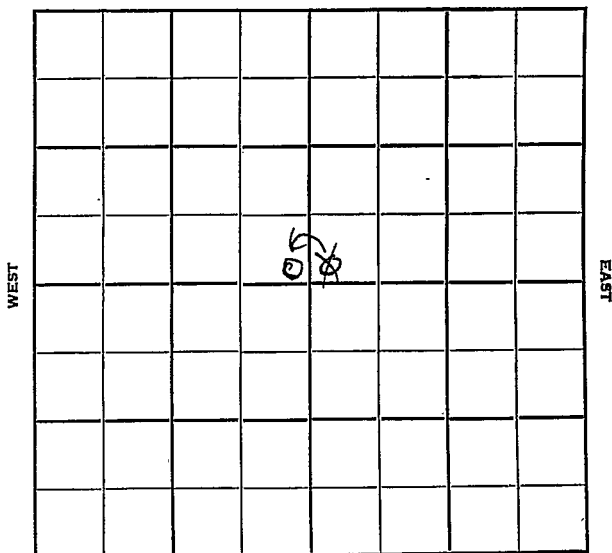

SOUTH

Haskell

KANSAS

Sec. 7 Twp. 28 R. 32W

Well No. #1 E. A. Cox <sup>11</sup>/<sub>11</sub> Farm

National Assoc. Pet. Company

Hugoton Pool Contractor


         Ft. from N. Line

100' Ft. from S. Line

100' Ft. from E. Line

         Ft. from W. Line

~~SW NE~~  
SE NW

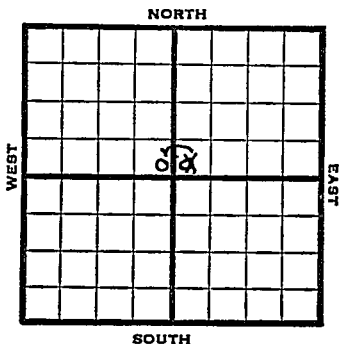

1950

Elev. 2951

REPORT

11/29

Spud 11-17-50  
8" @ 616'  
TD 2751  
5" @ 2750'

1951  
2/7

Spud 11/17/50  
Gas well TD 2773  
8" @ 616  
5" @ 2750 TD 2773  
Her. 2625 Win. 2750  
250/ 2625-83 5200 A  
Comp. 8,333,000 gas 390#

**COMPLETED**

County Haskell State Kansas  
 Sec. 7 (<sup>Blk.</sup><sub>Twp.</sub>) 28 (<sup>Sur.</sup><sub>Rge.</sub>) 32W Map No.  
 Operator National Assoc. Pet.  
 Well No. 1 Farm E. A. Cox "B"  
 Elev. \_\_\_\_\_ Location SW NE

|  |  |  |  |  |  |
|--|--|--|--|--|--|
|  |  |  |  |  |  |
|  |  |  |  |  |  |
0

FIRST REPORT

100 Ft. From S Line NE  
100 Ft. From W Line Quarter  
 1st. Report NOV 29 1950  
 Completion \_\_\_\_\_  
 Remarks \_\_\_\_\_

Spudding Date 11-17-50

Drlg. Data Hugoton Pool

8" @ 616 TD 2751 5" @ 2750

J. E. TYRA

Kansas

Map No. \_\_\_\_\_ Sec. 7 Twp. 28 R. 32WWell No. 1 Cox "B"\_\_\_\_\_  
National Assoc. Pet. \_\_\_\_\_ Company\_\_\_\_\_  
CORRECTION \_\_\_\_\_ Contractor

SE NW

## SECTION PLAT

\_\_\_\_\_  
Ft. from N. Line100  
Ft. from S. Line100  
Ft. from E. Line\_\_\_\_\_  
Ft. from W. Line

|  |  |  |  |
|--|--|--|--|
|  |  |  |  |
|  |  |  |  |
|  |  |  |  |
|  |  |  |  |
|  |  |  |  |

Haskell County

Location \_\_\_\_\_

Rig up \_\_\_\_\_

Drilling and Remarks:

Reported

SW NE

## RECORD

Cased \_\_\_\_\_ in., \_\_\_\_\_ ft.

Sand \_\_\_\_\_

Gas \_\_\_\_\_

Oil \_\_\_\_\_

Total Depth \_\_\_\_\_

## PRODUCTION

1st 24 hrs./Nat. \_\_\_\_\_

1st 24 hrs. after shot \_\_\_\_\_

Gas \_\_\_\_\_ Cu. Ft.

Dry Hole \_\_\_\_\_

Abandoned \_\_\_\_\_

Date

NOV 29 1950

19

J. E. TYRA Scout

County Haskell State Kansas

|      |   |                |    |                |     |         |
|------|---|----------------|----|----------------|-----|---------|
| Sec. | 7 | (Blk.<br>Twp.) | 28 | (Sur.<br>Rge.) | 32W | Map No. |
|------|---|----------------|----|----------------|-----|---------|

Operator National Assoc. Pet.

Well No. 1 Farm E. A. Cox "B"

Elev. 2951 Location SE NW

0

**COMPLETE**

100 Ft. From S Line NW

100 Ft. From E Line Quarter

1st. Report \_\_\_\_\_

Completion **FEB 7 1951**

|         |              |
|---------|--------------|
| Remarks | Hugoton Pool |
|---------|--------------|

Spudding Date 11-17-50

Drlg. Data      Gas well      TD 2773

8" @ 616      5" @ 2750      TD 2773

Her. 2625    Win. 2750    250/ 2625-83

5200 A      Comp. 8,333,000 gas      390#

J. E. TYRA