


Pratt KANSAS

Section 7 Township 28 Range 11-WWell No. #1 Levi HardingCompany Skelly et al

Cunningham Pool

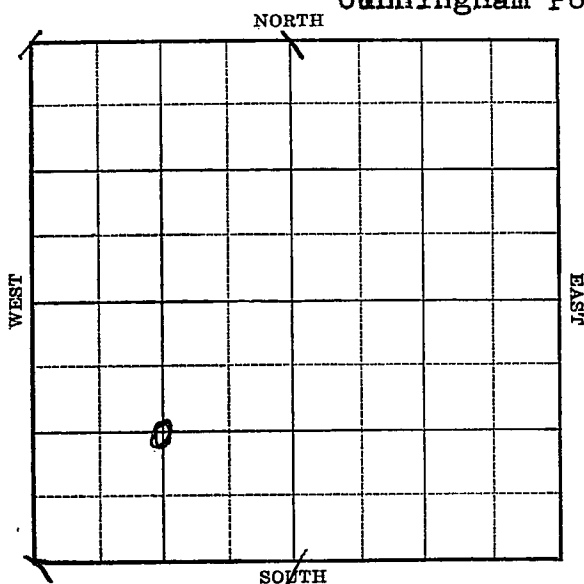

KANSAS

Pratt

Sec. 7 Twp. 28 R. 11-WWell No. #1 Levi Harding FarmSkelly et al Company

(Cunningham)


Ft. from N. Line

1320 Ft. from S. Line

Ft. from E. Line

1294 Ft. from W. Line

Elev. 1809

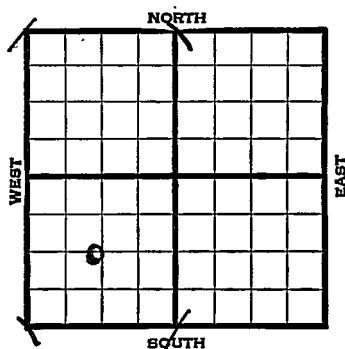

1939	REPORT
6/14	R.O.G.
6/23	Rotary.
6/29	13" - 250' Drlg. 1875'
7/6	Drlg. 2640'
7/13	Lans. 3606' S.O. 3606-10'
	S.O. 3649-59' Drlg. 3665'
7/20	Drlg. 4132'
7/27	Viola 4267 $\frac{1}{2}$ ' 5" 4268 $\frac{1}{2}$ '
	4270-72 12,000 cu. ft. gas
	4272-77 104,000 cu ft gas
	4277-4282 TD 802,000 cu ft gas
	Testing No oil showing (Tel)
8/2	Viola 4267 $\frac{1}{2}$ '
	5" - 4268 $\frac{1}{2}$ '
	T.D. 4283'
	802,000 cu. ft. gas.
	COMPLETED

Pratt


KANSAS

Map No. 54 Sec. 7 Twp. 28 R. 11WWell No. 1 Levi HardingSkelly Etal Company

Contractor

FIRST REPORT
C SW

SECTION PLAT

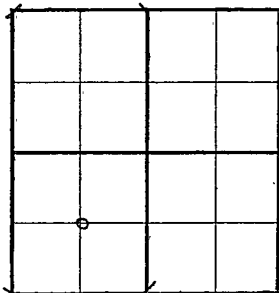 Ft. from N. Line1320 Ft. from S. Line Ft. from E. Line1294 Ft. from W. Line

CUNNINGHAM POOL

Location Rig up

Drilling and Remarks:

ROG

RECORD

Cased in., ft.Sand Gas Oil Total Depth

PRODUCTION

1st 24 hrs. Nat. 1st 24 hrs. after shot Gas Cu. Ft.Dry Hole Abandoned

Date

JUN 14 1939 19

S. J. LEWIS Scout

Map No. 54 Sec. 7 Twp. 28 R. 11WWell No. 1 Levi HardingSkelly etal

Company

Contractor


COMPLETED

C SW

 Ft. from N. Line1320 Ft. from S. Line Ft. from E. Line1294 Ft. from W. Line

CUNNINGHAM POOL

SECTION PLAT

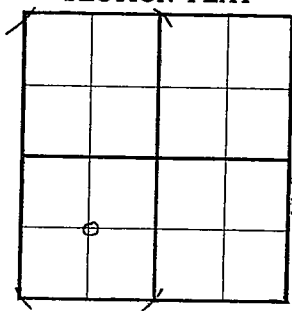Location Rig up

Drilling and Remarks:

*Viola 4267 1/2.**5" @ 4268 1/2**802,000 cu ft**Gas*

RECORD

Cased in., ft.Sand Gas Oil Total Depth 4283

PRODUCTION

1st 24 hrs. Nat. 1st 24 hrs. after shot Gas Cu. Ft.Dry Hole Abandoned

Date

AUG 2 1939

19

S. J. LEWIS

Scout