


KANSAS Sedgwick County

Section 8 Township 28 Range 1W

Well No. #1 Gorges

Company Model & Roland

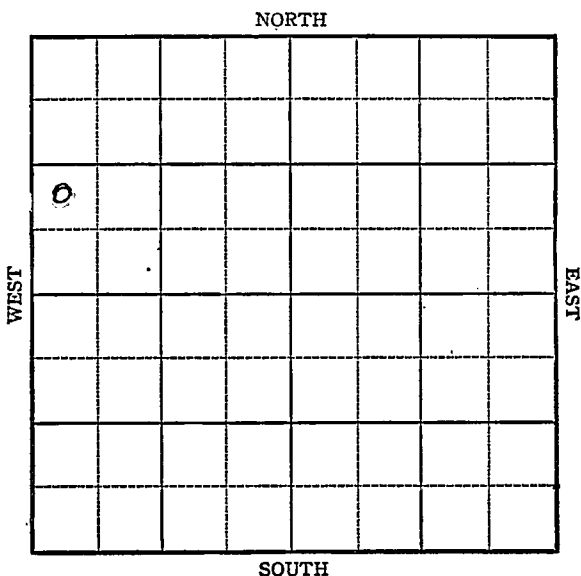

KANSAS

Sedgwick County

Sec. 8 Twp. 28 R. 1W

Well No. #1 Gorges Farm

Ode/Model & Roland Company


Wildcat

 Ft. from N. Line

990 Ft. from S. Line

 Ft. from E. Line

330 Ft. from W. Line

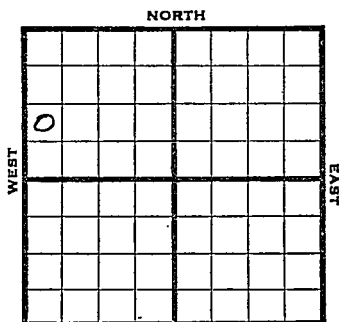

NW SW NW Ed. 1332

1944

R E P O R T

11/1	Derrick
11/8	10" @ 145 Drlg. 630
11/16	Lans 2783 Drlg. 2926
11/24	Drlg 3400
11/29	" "
12/6	Miss. 3348 Kind: 3604 Simp. 3670 TD 3678 Water

ABANDONED

Pool Name WildcatMap No. 38 Sec. 8 Twp. 28 R. 1WWell No. 1 GorgesModel & Roland


Company

FIRST REPORT

Contractor

NW SW NW

SECTION PLAT

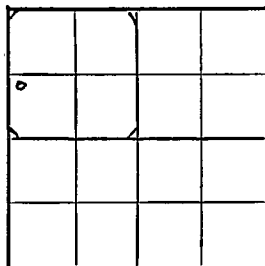 Ft. from N. Line990 Ft. from S. Line Ft. from E. Line330 Ft. from W. LineSedgwickLocation Rig up

Drilling and Remarks:

Derrick

RECORD

Cased in., ft.Sand Gas Oil Total Depth

PRODUCTION

1st 24 hrs. Nat. 1st 24 hrs. after shot Gas Cu. Ft.Dry Hole Abandoned

Date


NOV 1 1944 19S. J. LEWIS

Scout

Pool Name WildcatMap No. 38 Sec. 8 Twp. 28 R. 1WWell No. 1 GorgesOdel & Roland Company**CORRECTION**

Contractor

NW SW NW

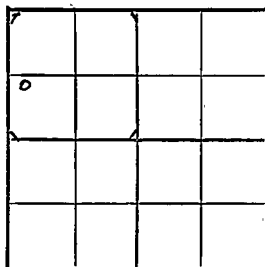SECTION PLAT Ft. from N. Line990 Ft. from S. Line Ft. from E. Line330 Ft. from W. LineSedgwickLocation Rig up

Drilling and Remarks:

Reported Model

and Roland

RECORDCased in., ft.Sand Gas Oil Total Depth **PRODUCTION**1st 24 hrs. Nat. 1st 24 hrs. after shot Gas Cu. Ft.Dry Hole Abandoned

Date

NOV 8 1944 19S. I. LEWIS

Scout

Pool Name WildcatMap No. 38 Sec. 8 Twp. 28 R. 1WWell No. 1 GorgesOdel & Roland CompanyABANDONED Contractor

NW SW NW

SECTION PLAT

6			

 Ft. from N. Line990 Ft. from S. Line Ft. from E. Line330 Ft. from W. LineSedgwickLocation Rig up

Drilling and Remarks:

Wells 3348
Wells 6864
Comp. 8670
Water

RECORD

Cased in., ft.Sand Gas Oil Total Depth 2678

PRODUCTION

1st 24 hrs. Nat. 1st 24 hrs. after shot Gas Cu. Ft.Dry Hole Abandoned

Date

DEC 6 1944 19 S. J. LEWIS Scout