


Section 8 Township 28 Range 5W

Well No. #1 Pilgram

Company Westgate-Greenland

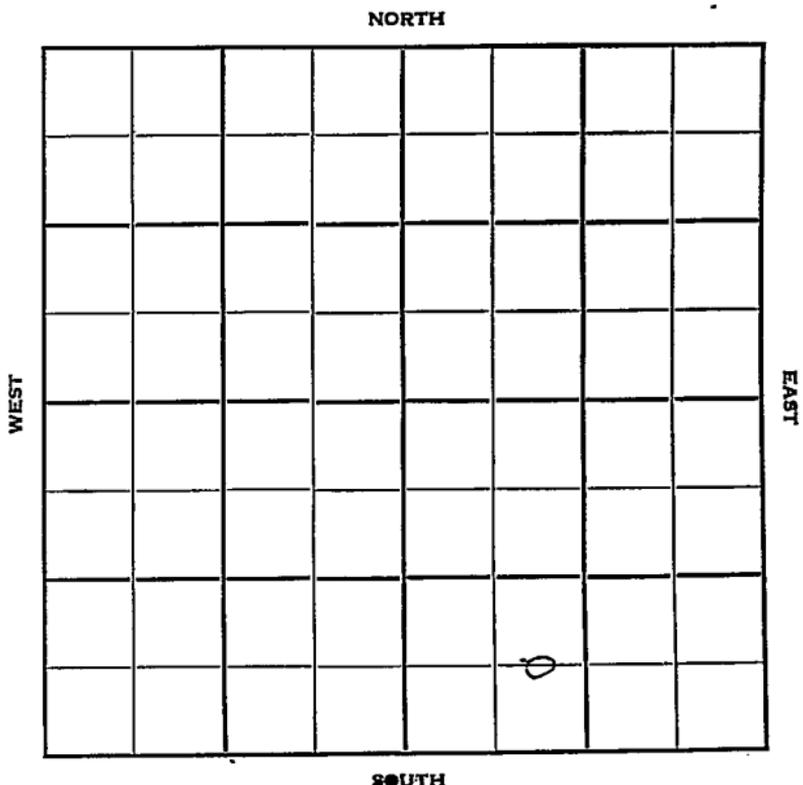

Sec. 8 Twp. 28 R. 5W ✓

Well No. #1 Pilgram Farm

Westgate-Greenland Company

Contractor


_____ Ft. from N. Line

660' Ft. from S. Line

_____ Ft. from E. Line

990' Ft. from W. Line

C E L SW SE

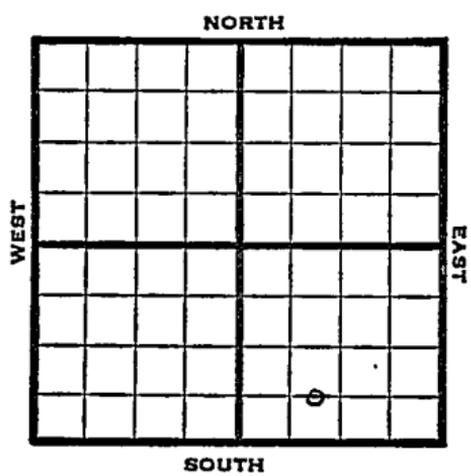

1950 Elev. 1398' REPORT

11/29

Location

6/13

Spud 12-3-50
D&A TD 4241
8" @ 202
Lans. 2963 Miss 3747
DST 3787-3808 opn 20 min
Rec. 630' oil, mud & wtr.
Est 1 mcfg 90' mo 110' m, w & o
Miss 3789 Viola 4163
Simp 4179 TD 4241
5" @ 3876 36/3790-98
SP 3794 12/3785-94 500 A
S/1/2 bo 25 bwph 1000 A
24/3780-92 1000 A S/1 goph
2000 A No inc. D&A

ABANDONED

County Kingman State Kansas

Sec. 8 (Blk. Twp.) 28 (Sur. Rge.) 5W Map No.

Operator Westgate-Greenland

Well No. 1 Farm Pilgram

Elev. _____ Location C E I. SW SE

660 Ft. From S Line SE

990 Ft. From W Line Quarter

1st. Report NUV 29 1950

Completion _____


Remarks _____

Spudding Date _____

Drlg. Data _____

Location

County Kingman State Kansas
 Sec. 8 (Blk. 28 (Sur. 5W Map No.
 (Twp.) (Rge.)
 Operator Westgate-Greenland
 Well No. 1 Farm Pilgram
 Elev. 1398 Location C E L SW SE

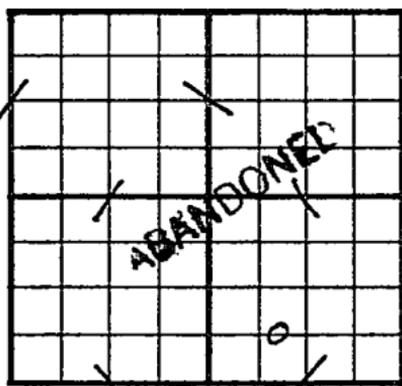

660 Ft. From S Line SE

990 Ft. From W Line Quarter

Ist. Report

Completion JUN 13 1951

Remarks

Spudding Date 12-3-50

Drlg. Data D & A TD 4241

8" @ 202 Lans. 2963 Miss. 3747

DST 3787-3808 open 20 min.

Rec. 630' oil, Mud & water

est. 1 mcfg 90' mo 110' m, w & o

Miss. 3789 Viola 4163 Simp. 4179

TD 4241 5" @ 3876 36/ 3790-98

SP 3794 12/ 3785-94 500. A

S/ 1/2 bo 25 bwph 1000 A

24/ 3780-92 1000 A S/ 1 goph

2000 A no inc.

D & A

J. E. TYRA