


Section 8 Township 28 Range 5W

Well No. #2 Viney "B"

Company Pabco Drlg.

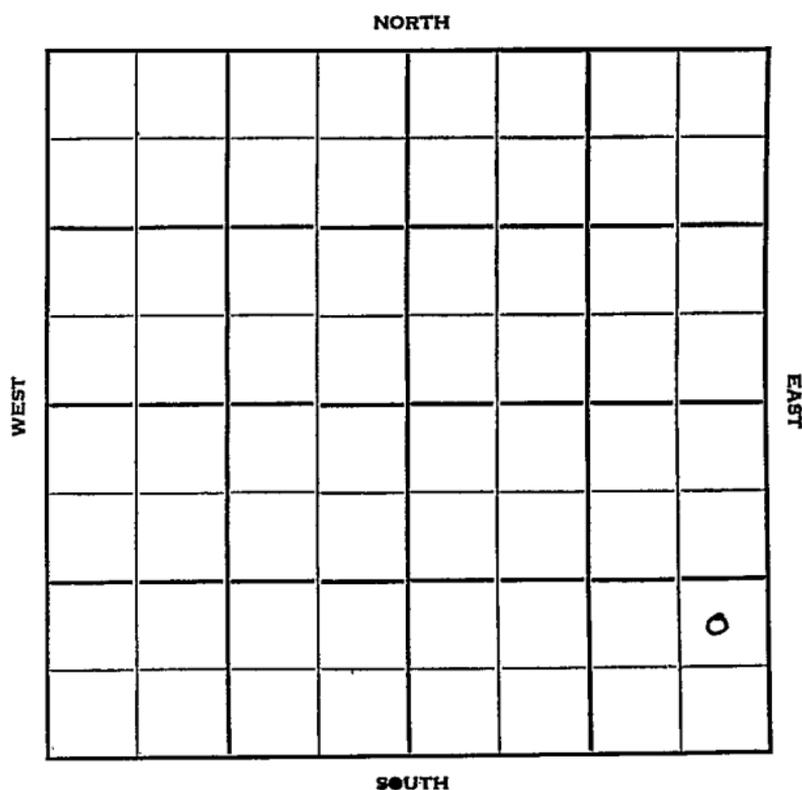

Kingman
28

KANSAS
5W ✓

Sec. 8 Twp. _____ R. _____

Well No. #2 Viney "B" Farm _____

Pabco Drlg. Company _____

Contractor _____


_____ Ft. from N. Line

990' Ft. from S. Line

330' Ft. from E. Line

_____ Ft. from W. Line

NE SE SE

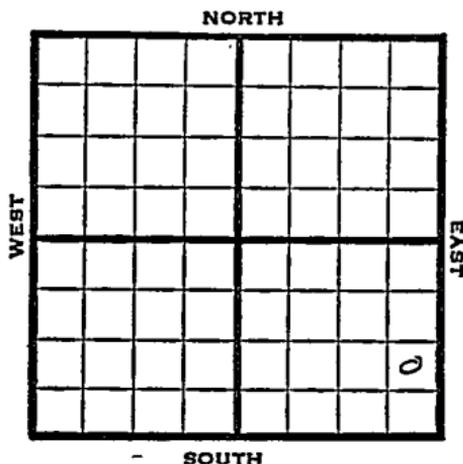

1950 Elev. 1398' REPORT

12/6 Spud 12-2-50
8" @ 140
Drlg. 950'

1951
2/28 Spud 12-2-50
Oil Well TD 3800
8" @ 140 Lans. 2969
Miss 3770
DST 3770-80 opn 1 hr
Rec. 60' mud
Miss dol. 3795
DST 3780- opn 1 hr
Rec. 210' geo 5" @ 3794
1000 A Comp. F/29 bopd 1½ mcfg.

COMPLETED

