


DX 78-1

Haskell KANSAS

Section 8 Township 28 Range 33 W

Well No. # 1 Mosbarger

Company Northern Natural

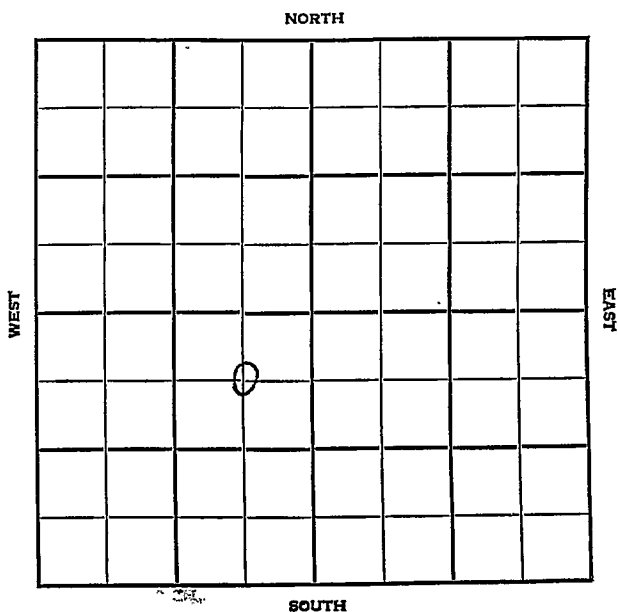

Haskell KANSAS

SEC. 8	TWP. 28	R. 33W
---------------	----------------	---------------

WELL NO. _____

1 Mosbarger FARM

COMPANY _____

Northern Natural

CONTRACTOR _____

Moran

Hugoton Pool


660 _____ Ft. from N. Line

_____ Ft. from S. Line

660 _____ Ft. from E. Line

_____ Ft. from W. Line

C NE SW

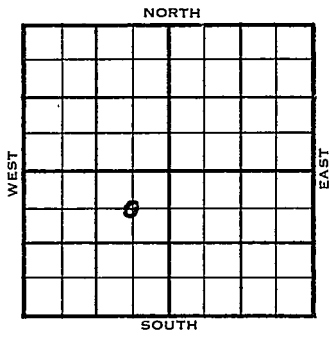

1955	ELEVATION	REPORT
	3004' 3 3006'	

2/16

Spud 2-10-55
9" @ 550'
Drlg. 2290'

3/16

Spud 2-10-55, gas well, TD
2785; 9" @ 550; Hol 2599, Her
2639, Kri 2662, O Dell 2713,
Win 2730, TD 2785, 5" @ 2775
CO to 2762 32/2746-54, 1750 A
frac 5000 A 647,000 CFG 44/
2 699-2710 2250 A frac 5000 A
1,000,000 cfg 40/2670-80, 3250 A
frac 8000 A
Comp 5,060,000 CFGPD 395#

COMPLETED

County Haskell State Kansas

Sec. 8 (Blk. 28) (Sur. 33W) (Twp. 33W) Map No.

Operator Northern Natural

Well No. 1 Farm Mosbarger

Elev. 3004 Location C NE SW

FIRST REPORT

660 Ft. From N Line SW

660 Ft. From E Line Quarter

FEB 16 1955

Ist. Report

Completion

Remarks

Moran - Contr.

Spudding Date 2-10-55

Drig. Data Hugoton Pool

9" @ 550 drlg. 2290

County Haskell State Kansas

Sec. 8 (Blk. 28 (Sur. 33W Map No. (Twp.))

Operator Northern Natural

Well No. 1 Farm Mosbarger

Elev. 3006 Location C NE SW

660 Ft. From N Line SW

660 Ft. From E Line Quarter

Ist. Report

Completion MAR 23 1955

Remarks Hugoton Pool

Moran - Contr.

Spudding Date 2-10-55

Drlg. Data Gas well TD 2785

9" @ 550 Hol. 2599 Her. 2639

Kri. 2662 O'Dell 2713 Win. 2730

TD 2785 5" @ 2775 CO to 2762

32/ 2746-54 1750A frac 5000 A

647,000 cfg - 44/ 2699-2710 2250 A

frac 5000 A 1,000,000 cfg

40/ 2670-80. 3250 A frac 8000 A

Comp. 5,060,000 cfgpd 395#.

FABEN GILSTRAP