

**KANSAS**Section 8 Township 28 Range 36WWell No. 1 BarnesCompany Magnolia

Hugoton

NORTH

|  |  |  |  |   |  |  |  |
|--|--|--|--|---|--|--|--|
|  |  |  |  |   |  |  |  |
|  |  |  |  |   |  |  |  |
|  |  |  |  |   |  |  |  |
|  |  |  |  |   |  |  |  |
|  |  |  |  | D |  |  |  |
|  |  |  |  |   |  |  |  |
|  |  |  |  |   |  |  |  |
|  |  |  |  |   |  |  |  |

WEST

EAST

SOUTH

Grant

Sec. 8 Twp. 28 R. 36W

Well No. #1 Barnes Farm

Magnolia Company


Hugoton (Barnett Drlg., Cont.)  
Pool

330' Ft. from N. Line

       Ft. from S. Line

       Ft. from E. Line

330' Ft. from W. Line

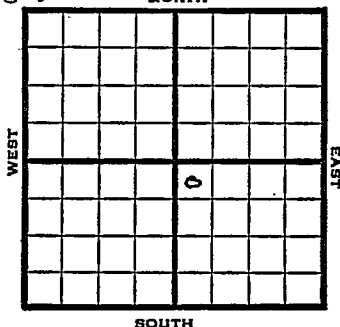

NW SE

1949

Elev. 3096' REPORT

|      |                                   |
|------|-----------------------------------|
| 7/20 | Location                          |
| 7/27 | 10" @ 730'                        |
|      | Drlg 2220'                        |
| 8/3  | TD 2775'                          |
|      | 7" @ 2768'                        |
| 8/10 | "                                 |
| 8/17 | 380 shots 2562-2702 - 21,000 acid |
| 8/24 | 196 shots 2479-2542-21000 acid    |
| 8/31 | "                                 |
| 9/7  | 7" @ 2768'                        |
|      | Perf                              |
|      | Acid 42,000                       |
|      | Gas 16,800,000                    |
|      | R Pr. 392#                        |
|      | TD 2775'                          |

**COMPLETED**

Kansas

Map No. \_\_\_\_\_ Sec. 8 Twp. 28 R. 36W

Well No. 1 Barnes

Magnolia Company

Barnett Drlg. Contractor

NW SE


FIRST REPORT  
SECTION PLAT

330 Ft. from N. Line

\_\_\_\_\_ Ft. from S. Line

\_\_\_\_\_ Ft. from E. Line

330 Ft. from W. Line

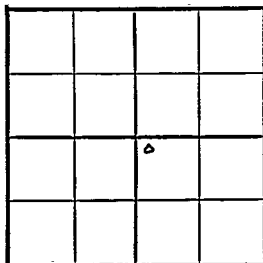

Grant County

Location X

Rig up

Drilling and Remarks:

## RECORD

Cased \_\_\_\_\_ in., \_\_\_\_\_ ft.

Sand \_\_\_\_\_

Gas \_\_\_\_\_

Oil \_\_\_\_\_

Total Depth \_\_\_\_\_

## PRODUCTION

1st 24 hrs. Nat. \_\_\_\_\_

1st 24 hrs. after shot \_\_\_\_\_

Gas \_\_\_\_\_ Cu. Ft.

Dry Hole \_\_\_\_\_

Abandoned \_\_\_\_\_

Date

JUL 20 1949 19

S. J. LEWIS

Scout

Map No. 1 Sec. 8 Twp. 28 R. 36W

Well No. 1 Barnes

Magnolia Company

COMPLETE

Contractor

NW SE

E13096  
SECTION PLAT

|  |  |   |  |
|--|--|---|--|
|  |  |   |  |
|  |  |   |  |
|  |  | 6 |  |
|  |  |   |  |

330 Ft. from N. Line

       Ft. from S. Line

       Ft. from E. Line

330 Ft. from W. Line

Grant County

Location       

Rig up       

Drilling and Remarks:

7" C2768

Perf  
42000 Acid

16,800,000 Gas

392 \* R/P

RECORD

Cased        in.,        ft.

Sand       

Gas       

Oil       

Total Depth 2725

PRODUCTION

1st 24 hrs. Nat.       

1st 24 hrs. after shot       

Gas        Cu. Ft.

Dry Hole       

Abandoned       

Date

SEP 7 1949 19

S. J. LEWIS Scout