


Section 8 Township 28 Range 39WWell No. 1 KerneyCompany Stanolind

Hugoton

NORTH

WEST

EAST

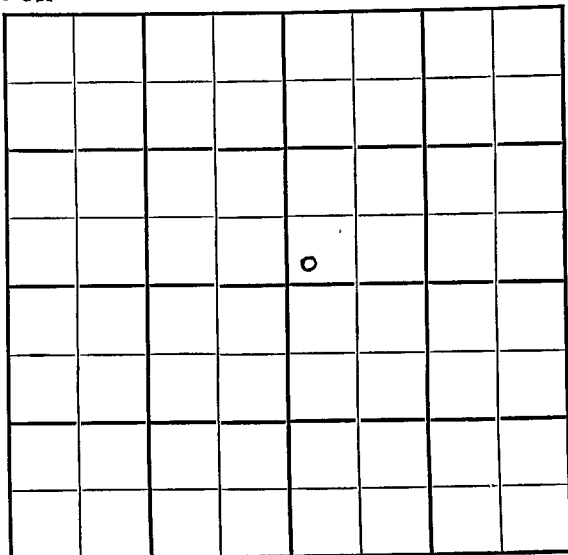

SOUTH

8 KANSAS 28 39W
Sec. Twp. R.

Well No. #1 Kerney Farm

Stanolind Company

Hugoton


Ft. from N. Line

150 Ft. from S. Line

Ft. from E. Line

150 Ft. from W. Line

SW NE

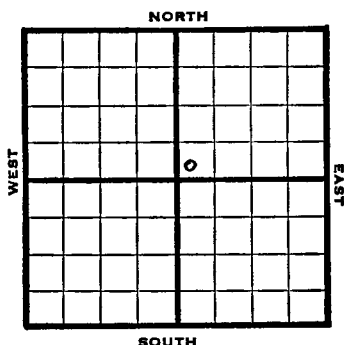

1947	Elev. 3184' REPORT
11/5	Location
11/12	RUR
11/19	TD 2285' 10" @ 708'
11/25	"
12/3	TD 2485' 221' of 5" Perf. liner @ 2485'
12/10	7" @ 2281' 221' of 5" Perf. Liner @ 2485' 16000 acid, 4,513,000 gas. 425# R. Pr. TD 2485'
	COMPLETED

Hugoton Pool

Form 26 200 Bks. 10-46 Petrol
Kansas

Map No. _____ Sec. 8 Twp. 28 R. 39W

Well No. 1 Kerney

Stanolind Company

TEST REPORT Contractor

SW NE

SECTION PLAT

		0	

_____ Ft. from N. Line

150 Ft. from S. Line

_____ Ft. from E. Line

150 Ft. from W. Line

Stanton County

Location X

Rig up _____

Drilling and Remarks:

RECORD

Cased _____ in., _____ ft.

Sand _____

Gas _____

Oil _____

Total Depth _____

PRODUCTION

1st 24 hrs. Nat. _____

1st 24 hrs. after shot _____

Gas _____ Cu. Ft.

Dry Hole _____

Abandoned _____

Date

NOV 5 1947

19

S. J. LEWIS

Scout

Map No. _____ Sec. 8 Twp. 28 R. 39W


Well No. 1 Kerney

Stanolind Company

COMPLETE Contractor

SW NE

E13184
SECTION PLAT

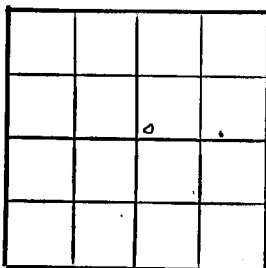

_____ Ft. from N. Line

150 Ft. from S. Line

_____ Ft. from E. Line

150 Ft. from W. Line

Stanton County

RECORD

Location _____

Rig up _____

Drilling and Remarks:

7" @ 2281

221' x 5' by line

@ 2475

16000 ac @

4,513,000 Gal

425 # R/A

Cased _____ in., _____ ft.

Sand _____

Gas _____

Oil _____

Total Depth 2475'

PRODUCTION

1st 24 hrs. Nat. _____

1st 24 hrs. after shot _____

Gas _____ Cu. Ft.

Dry Hole _____

Abandoned _____

Date

10 10 1947 19

S. J. LEWIS Scout