

Section 8 Township 28 Range 13WWell No. #1 SmithCompany G-M-R Oil

				0			

NORTH

WEST

EAST

SOUTH

HOT FILE

Pratt

KANSAS

Sec. 8 Twp. 28 R. 13 W 2Well No. # 1 Smith FarmG-M-R Oil


Company

Contractor

WildcatFt. from N. Line330 Ft. from S. LineFt. from E. Line330 Ft. from W. Line

SW SW NE

MCPC has SE of 5 & NW of 7

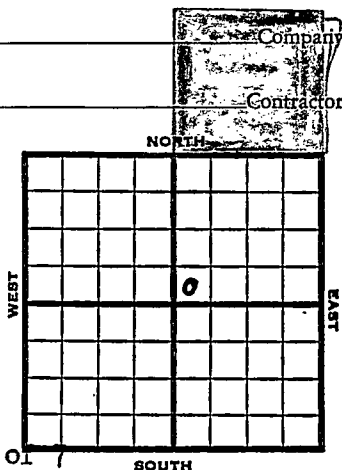

1953 Elev. 1893'

REPORT

8/12 MIR

8/20 Spudded 8-11-53

8" @ 225 w/161 Anhy 703'

DST 3175-3210, open 1 hr rec 90'

SW 750#

Drlg. 3444' No tops. (Ltr-McGehee)

8/27 Br. lime 3809' Lans 3828'

DST 4162-90 open 1 hr rec 10' mud Off

Miss 4230' Miss. chert 4280'

Viola 4348' Simp sh. 4419'

Arb. 4518'

Drlg. 4529' (Ltr-McGehee)

9/2 Spud 8-11-53

D & A

TD 4548'

8" @ 255'

Anhy 703

DST 3175-3210 opn 1 hr, rec 90' sw

750# Br. Lime 3809, Lans 3828

DST 4162-90 opn 1 hr, rec 10' mud Off

Miss Lime 4230, Miss Chert 4280, Viola

4348, Simp 4419, Arb 4518


TD 4548'

D & A

ABANDONED

J. G. McGEHEE

County Pratt State Kansas
 Sec. 8 (Blk.) 28 (Sur.) 13W Map No.
 Operator G-M-R Oil
 Well No. 1 Farm Smith
 Elev. 1893 Location SW SW NE

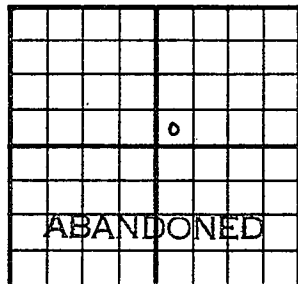

330 Ft. From S Line NE
330 Ft. From W Line Quarter
 Ist. Report
 Completion SFP 2 1953
 Remarks Wildcat
G-M-R - Contr.
 Spudding Date 8-11-53

Drilg. Data D & A TD 4548
8" @ 255 Anhy 703 DST 3175-3210
open 1 hr. Rec. 90' sw 750#
Br. lime 3809 Lans. 3828 DST 4162-90
open 1 hr. Rec. 10' mud 0#
Miss. lime 4230 Miss. chert 4280
Viola 4348 Simp. 4419 Arb. 4518
TD 4548

D & A