


Section 8 Township 28 Range 11-WWell No. #1 GoyenCompany Skelly Oil

NORTH

Cunningham Pool

WEST

EAST

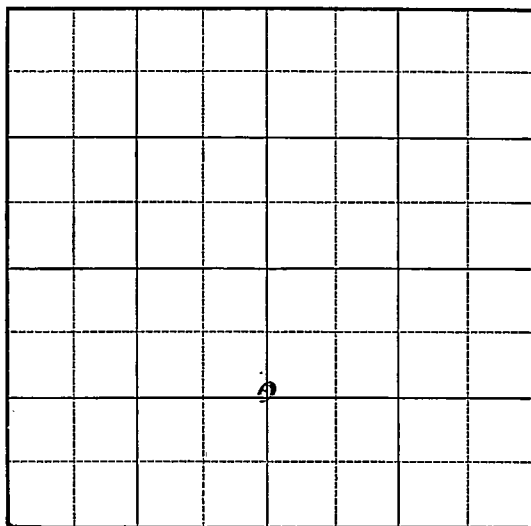

SOUTH

# KANSAS, Pratt

FORM 252-A 5M 2-40

Sec. 8 Twp. 28 R. 11-W

Well No. #1 Goyen Farm \_\_\_\_\_

Skelly Oil Company \_\_\_\_\_

(Cunningham)


\_\_\_\_\_ Ft. from N. Line

1335 Ft. from S. Line

2640 Ft. from E. Line

\_\_\_\_\_ Ft. from W. Line

Elev. 1772

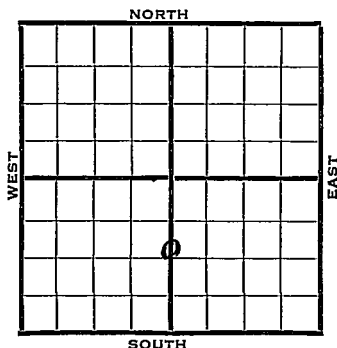

| 1940  | REPORT                       |              |
|-------|------------------------------|--------------|
| 7/24  | Pits.                        |              |
| 8/2   | 8-5/8" - 343' WOC.           |              |
| 8/8   | Drlg. 3055'                  |              |
| 8/14  | Lans 3587'                   |              |
|       | Viola 4231-34 T.D.           |              |
|       | 5" 4231 RUST                 |              |
| 8/22  | Drlg. 4238' 8½ M gas. S.S.O. |              |
| 8/29  | T.D. 4245' 1000 acid.        |              |
|       | 36 M gas.                    |              |
| 9/5   | " "                          |              |
| 9/12  | " "                          |              |
| 9/19  | " "                          |              |
| 9/26  | " "                          | 4231<br>1772 |
| 10/3  | " "                          | 2459         |
| 10/10 | " "                          |              |
| 10/17 | " "                          |              |
|       |                              |              |
| 10/23 | Viola 4231'                  |              |
|       | 5" - 4231'                   |              |
|       | T.D. 4245' 1000 acid.        |              |
|       | Flow 419 oil. 9 M gas.       |              |
|       | COMPLETED                    |              |

Map No. 54 Sec. 8 Twp. 28 R. 11WWell No. 1 GoyenSkelly Oil

Company

Contractor


## FIRST REPORT

C S L N $\frac{1}{2}$  S $\frac{1}{2}$  Sec.

## SECTION PLAT

       Ft. from N. Line1335 Ft. from S. Line2640 Ft. from E. Line       Ft. from W. Line

CUNNINGHAM POOL

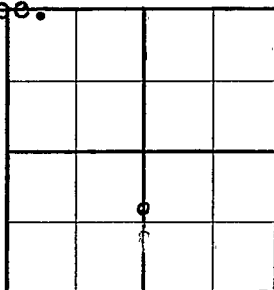Location                                 Rig up                                 

Drilling and Remarks:

Pits

## RECORD

Cased            in.,            ft.Sand                                 Gas                                 Oil                                 Total Depth                                 

## PRODUCTION

1st 24 hrs. Nat.                                 1st 24 hrs. after shot                                 Gas                                  Cu. Ft.Dry Hole                                 Abandoned                                 

Date

JUL 24 1940 19

S. J. LEWIS Scout

Map No. 54 Sec. 8 Twp. 28 R. 11WWell No. 1 GoyenSkelly Oil Company

Contractor

COMPLETED

## SECTION PLAT

C S L N  $\frac{1}{2}$  S  $\frac{1}{2}$  Sec.       Ft. from N. Line1335 Ft. from S. Line2640 Ft. from E. Line       Ft. from W. Line

CUNNINGHAM POOL

|  |  |  |  |
|--|--|--|--|
|  |  |  |  |
|  |  |  |  |
|  |  |  |  |
|  |  |  |  |

Location       Rig up       

Drilling and Remarks:

*Vidlar 4231**5" @ 4231**1000 acid**Flood 419 oil**9M Gas*

## RECORD

Cased        in.,        ft.Sand       Gas       Oil       Total Depth 4245

## PRODUCTION

1st 24 hrs. Nat.       1st 24 hrs. after shot       Gas        Cu. Ft.Dry Hole       Abandoned       

Date

OCT 23 1940 19S. J. LEWIS Scout