

KANSAS

FORM 51 IOM 12-46 PETROL


KANSAS

Pratt county

Section 8 Township 28 Range 11-W

Well No. #1, Goyen Est.

Company Bennett and Roberts

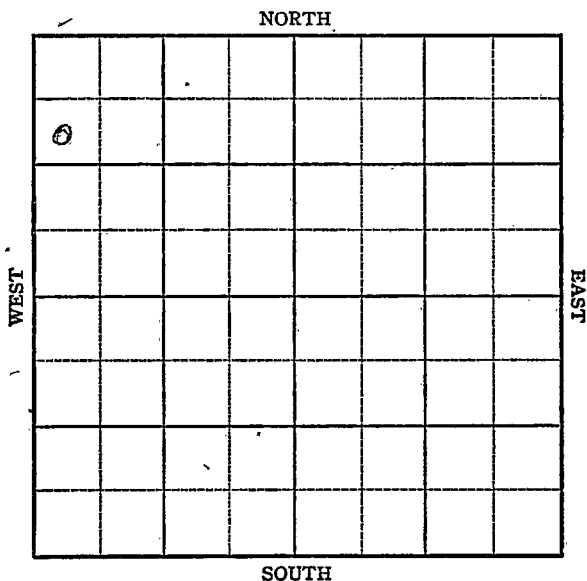

KANSAS

Pratt county

Sec. 8 Twp. 28 R. 11-W

Well No. #1, Goyen Est Farm
Bennett and Roberts Company
Wildcat


990' Ft. from N. Line

_____ Ft. from S. Line

_____ Ft. from E. Line

330' Ft. from W. Line

SW NW NW

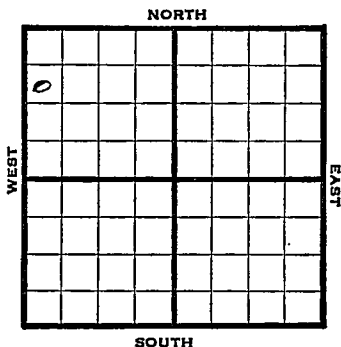

1946 REPORT
Elev. 1792

12/18 10" @ 367'
WOC

1947

1/4 Lans 3588'
TD 3600'
7" @ 3597, RUST

1/8 " "

1/15 Drlg 3701'
SD & W

1/21 TD 3742'W
PB 3665

1/29 TD 3742'
Lans 3588
7" @ 3597
5000 Acid

ABANDONED

Map No. _____ Sec. 8 _____ Twp. 28 _____ R. 11W

Well No. 1 Goyen Est. _____


Bennett & Roberts _____ Company

FIRST REPORT

Contractor _____

SW NW NW

SECTION PLAT

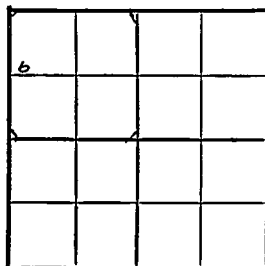

990 Ft. from N. Line

Ft. from S. Line

Ft. from E. Line

330 Ft. from W. Line

Pratt County

Location _____

Rig up _____

Drilling and Remarks:

10" @ 367 WOC

RECORD

Cased _____ in. _____ ft.

Sand _____

Gas _____

Oil _____

Total Depth _____

PRODUCTION

1st 24 hrs. Nat. _____

1st 24 hrs. after shot _____

Gas _____ Cu. Ft.

Dry Hole _____

Abandoned _____

Date

DEC 1 8 1946 19 _____ S. J. LEWIS Scout

54

Map No. 54 Sec. 8 Twp. 28 R. 11W

Well No. 1 Goyen Est.

Bennett & Roberts


Company

ABANDONED

Contractor

SW NW NW

E11792
SECTION PLAT

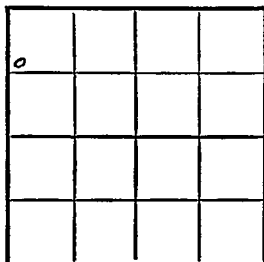

990 Ft. from N. Line

 Ft. from S. Line

 Ft. from E. Line

330 Ft. from W. Line

Pratt County

Location

Rig up

Drilling and Remarks:

*Lions 3588.
7" 3587
5000 acid*

RECORD

Cased in. ft.

Sand

Gas

Oil

Total Depth 3742

PRODUCTION

1st 24 hrs. Nat.

1st 24 hrs. after shot

Gas Cu. Ft.

Dry Hole

Abandoned

Date

JAN 29 1947 19

S. J. LEWIS

Scout