

KANSAS

Form 51-5M-7-40-Palace


Pratt

Section 8 Township 28 Range 11-W

Well No. #1 Goyen "C"

Company Skelly Oil

NORTH Cunningham Pool

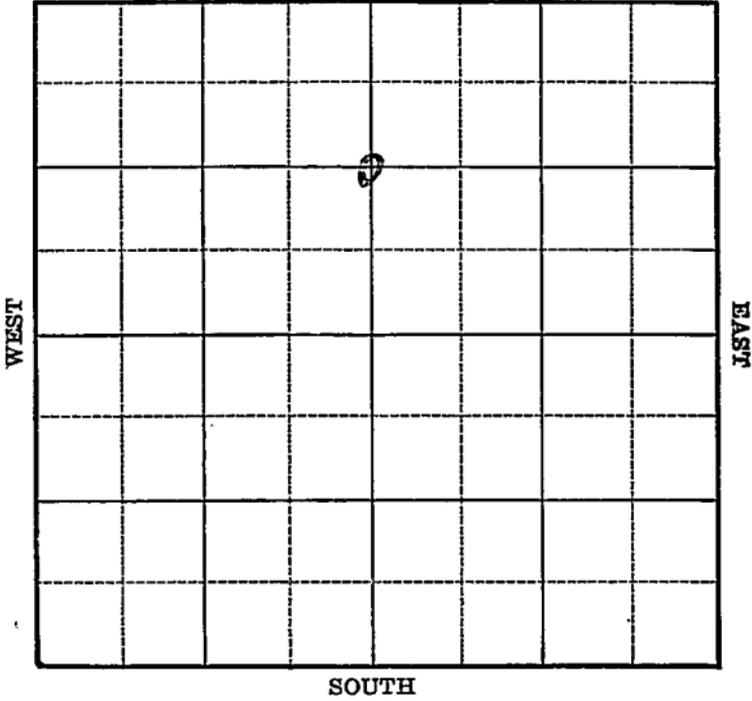

Sec. 8 Twp. 28 R. 11-WWell No. #1 Goyen "C" FarmSkelly Oil Company

(Cunningham)


1320 Ft. from N. Line

_____ Ft. from S. Line

2640 Ft. from E. Line

_____ Ft. from W. Line

Elev. 1755

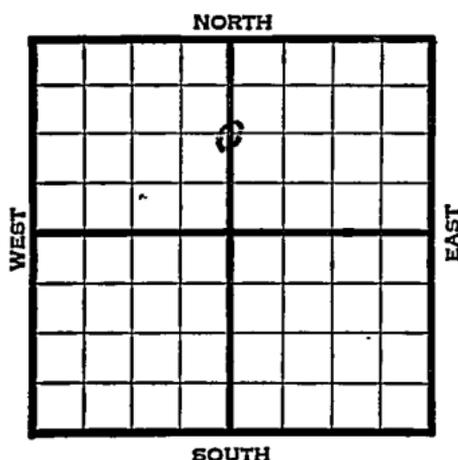

1940	REPORT
12/18	Derrick.
12/26	Rigging up.
1941	
1/2	8" - 398' Drlg. 800'
1/9	Drlg. 3950'
1/16	Lans. 3560' Viola 4200 ⁴²⁰⁵ $\frac{1}{2}$ ' 4205 $\frac{1}{2}$ ' 4" - 4202 ⁴²⁰⁷ T.D. 4204' RUST.
1/23	Viola 4205 $\frac{1}{2}$ ' (Corrected) 4" - 4207 $\frac{1}{2}$ ' Drlg. 4227'
1/30	T.D. 4238' 30 qts. 4212-18' 4000 acid. 14 M gas.
2/5	Viola 4205 $\frac{1}{2}$ ' 4" - 4207 $\frac{1}{2}$ ' T.D. 4238' Shot 30 qts. 4212-28' 4000 acid. 9,251,000 gas.
	COMPLETED

Map No. 54 Sec. 8 Twp. 28 R. 11WWell No. 1 Goyen "C"Skelly Oil Company

Contractor

FIRST REPORT

C N $\frac{1}{2}$ Sec.1320 Ft. from N. Line


_____ Ft. from S. Line

2640 Ft. from E. Line

_____ Ft. from W. Line

CUNNINGHAM POOL

SECTION PLAT

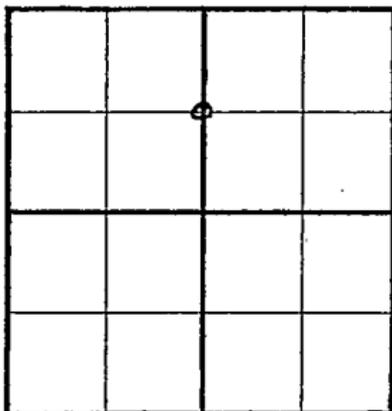

Location _____

Rig up _____

Drilling and Remarks:
Derrick

RECORD

Cased _____ in., _____ ft.

Sand _____

Gas _____

Oil _____

Total Depth _____

PRODUCTION

1st 24 hrs. Nat. _____

1st 24 hrs. after shot _____

Gas _____ Cu. Ft.

Dry Hole _____

Abandoned _____

Date

DEC 18 1940₁₉S. J. LEWIS Scout

Map No. 54 Sec. 8 Twp. 28 R. 11WWell No. 1 Goyen "C"Skelly Oil Company

Contractor

COMPLETED

SECTION PLAT

C $N\frac{1}{2}$ Sec.1320 Ft. from N. Line

_____ Ft. from S. Line

2640 Ft. from E. Line

_____ Ft. from W. Line

CUNNINGHAM POOL

Location: _____

Rig up _____

Drilling and Remarks:

*Vidua 4205 1/2**4" @ 4207 1/2**30 gts 4212-25.**4000 acd**9,251,000 Gas*

RECORD

Cased _____ in., _____ ft.

Sand _____

Gas _____

Oil _____

Total Depth 4238

PRODUCTION

1st 24 hrs. Nat. _____

1st 24 hrs. after shot _____

Gas _____ Cu. Ft.

Dry Hole _____

Abandoned _____

Date

FEB 5 1941 19S. J. LEWIS Scout