


Section 9 Township 28 Range 5 W

Well No. #3 Viney "B"

Company Pabco Drlg.

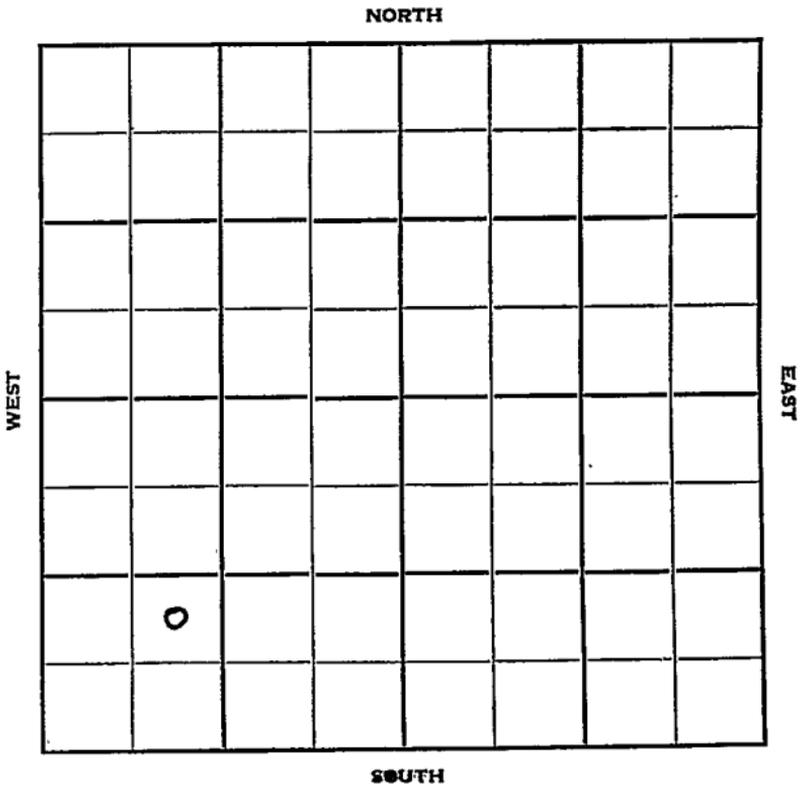

Sec. 9 Twp. 28 R. 5W

Well No. #3 Viney "B" Farm

Pabco Drlg. Company

Pabco Drlg. - Contr. Contractor

Dewey Pool


\_\_\_\_\_ Ft. from N. Line

990' Ft. from S. Line

\_\_\_\_\_ Ft. from E. Line

990' Ft. from W. Line

NE SW SW

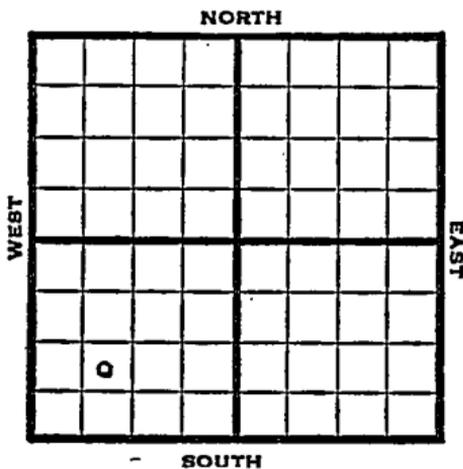

1951 Elev. 1412' REPORT

1/24 Spd 1-19-51  
8" @ 154'  
Drlg. 2100'

4/25 Spud 1-19-51  
Oil Well TD 3883  
8" @ 154  
Br Lime 2962 Lans. 2983  
Miss 3795'  
DST 3812-20 opn 1 hr  
Rec. 90' gcm Miss dol. 3846-83  
DST 3829-47 opn 1 hr Rec. 18' mud  
DST 3847-64 opn 1 hr Rec. 290' ocm  
TD 3883 5" @ 3833  
12/3841-43 500 A S/12 boph  
Comp. 84 bopd

**COMPLETED**



